STATE OF VERMONT
AGENCY OF TRANSPORTATION

TRAFFIC SIGN SUMMARY SHEET 08

MILEMARKER, STATION, OR SIGN NUMBER	SIGN LEGEND	SIGN DIMENSIONS EA	SIGN DIMENSIONS WIDTH (in)	SIGN DIMENSIONS HEIGHT (in)	NEW & SALVAGED SIGNS "A"	NEW & SALVAGED SIGNS "B"	NEW & SALVAGED SIGNS SALV SIGN	NEW & SALVAGED SIGNS SALV TIS	EXIST POST RETAIN	EXIST POST SALVAGE	NEW SIGN POSTS NO. OF POSTS	FLANGED CHANNEL lb/ft 1.12	FLANGED CHANNEL lb/ft 2.0	FLANGED CHANNEL lb/ft 3.0	SQUARE STEEL (in) lb/ft 1.75	SQUARE STEEL (in) lb/ft 2.0	SQUARE STEEL (in) lb/ft 2.5	ANCHOR	SLEEVE	TUBULAR ALUMINUM Ø (in) lb/ft 3.0	TUBULAR ALUMINUM Ø (in) lb/ft 4.0	TUBULAR ALUMINUM Ø (in) lb/ft 4.0 MOD	FOUND-ATION	TUBULAR STEEL Ø (in) lb/ft 3.0	TUBULAR STEEL Ø (in) lb/ft 3.5	TUBULAR STEEL Ø (in) lb/ft 4.0	TUBULAR STEEL Ø (in) lb/ft 5.0	W-SHAPE STEEL FTG. SIZE 24"	W-SHAPE STEEL FTG. SIZE 30"	W-SHAPE STEEL WEIGHT	W-SHAPE STEEL POST SIZE	STIGNE	FRAME REQUIRED	REMARKS	SIGN DETAIL DETAIL IN SHSM BOOK	SIGN DETAIL DETAIL ON SHEET NUMBER	SIGN DETAIL STD. SHEET NUMBER
U.S. ROUTE 2 BURLINGTON																																					
17+25, LT		1	9	15	0.94																												RIO-3e MOUNT ON SIGNAL POLE USING NEW MOUNTING HARDWARE (INCIDENTAL TO SIGN)	X		
17+49, RT		1	9	15	0.94																												RIO-3e MOUNT ON SIGNAL POLE USING NEW MOUNTING HARDWARE (INCIDENTAL TO SIGN)	X		
17+90, LT		1	40	30	8.33						2					27' X		X																		90	
18+55, ℄	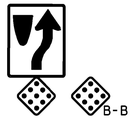	1 1 1	24 18 18	30 18 18	5.00 2.25 2.25																												R4-7 MOUNT ON SIGNAL POLE USING NEW MOUNTING HARDWARE (INCIDENTAL TO SIGN) OMI-1 OMI-1	X X X		
19+62, ℄	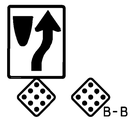	1 1 1	24 18 18	30 18 18	5.00 2.25 2.25																												R4-7 MOUNT ON SIGNAL POLE USING NEW MOUNTING HARDWARE (INCIDENTAL TO SIGN) OMI-1 OMI-1	X X X		
23+41, ℄		1 1 1 1	36 24 18 18	36 30 18 18	9.00 5.00 2.25 2.25																												R3-4 R4-7 MOUNT ON SIGNAL POLE USING NEW MOUNTING HARDWARE (INCIDENTAL TO SIGN) OMI-1 OMI-1	X X X X		
23+48, RT		1	9	15	0.94																												RIO-3e MOUNT ON SIGNAL POLE USING NEW MOUNTING HARDWARE (INCIDENTAL TO SIGN)	X		
23+90, LT		1	9	15	0.94																												RIO-3e MOUNT ON SIGNAL POLE USING NEW MOUNTING HARDWARE (INCIDENTAL TO SIGN)	X		
												FT	FT	FT	FT	FT ~~30~~ 27	FT		EA	LB	LB	LB		LB	LB	LB	LB									
FINAL POST LENGTHS ARE TO BE DETERMINED IN THE FIELD. POST SIZES ARE COMPUTED BASED ON INFORMATION FURNISHED ON THE STANDARD SHEETS AND THE VTRANS "SIGN POST DESIGN GUIDELINE."		**TOTALS**	SF 49.59	SF	EA.	SF						FT			FT ~~30~~ 27					LB				EA.	LB				EA.	EA.	LB					

PROJECT NAME: BURLINGTON-SOUTH BURLINGTON
PROJECT NUMBER: NH 2624(1)

FILE NAME: p06d216.dgn
PROJECT LEADER: JLL
DESIGNED BY: STANTEC
IPARM FILE: p06d216tss08.i

PLOT DATE: 2/7/2012
DRAWN BY: STANTEC
CHECKED BY: STANTEC
SHEET 61 OF 108