STATE OF VERMONT
AGENCY OF TRANSPORTATION

TRAFFIC SIGN SUMMARY SHEET 25

MILEMARKER, STATION, OR SIGN NUMBER	SIGN LEGEND	SIGN DIMENSIONS EA	SIGN DIMENSIONS WIDTH (in)	SIGN DIMENSIONS HEIGHT (in)	NEW & SALVAGED SIGNS "A"	NEW & SALVAGED SIGNS "B"	NEW & SALVAGED SIGNS SALV SIGN	NEW & SALVAGED SIGNS SALV TIS	EXIST POST RETAIN	EXIST POST SALVAGE	NEW SIGN POSTS NO. OF POSTS	FLANGED CHANNEL lb/ft 1.12	FLANGED CHANNEL lb/ft 2.0	FLANGED CHANNEL lb/ft 3.0	SQUARE STEEL (in) lb/ft 1.75	SQUARE STEEL (in) lb/ft 2.0	SQUARE STEEL (in) lb/ft 2.5	ANCHOR	SLEEVE	TUBULAR ALUMINUM Ø (in) lb/ft 3.0	TUBULAR ALUMINUM Ø (in) lb/ft 4.0	TUBULAR ALUMINUM Ø (in) lb/ft 4.0 MOD	FOUND-ATION	TUBULAR STEEL Ø (in) lb/ft 3.0	TUBULAR STEEL Ø (in) lb/ft 3.5	TUBULAR STEEL Ø (in) lb/ft 4.0	TUBULAR STEEL Ø (in) lb/ft 5.0	W-SHAPE STEEL FTG. SIZE 24"	W-SHAPE STEEL FTG. SIZE 30"	W-SHAPE STEEL WEIGHT	W-SHAPE STEEL POST SIZE	FRAME SIGNS	REQUIRED	REMARKS	SIGN DETAIL DETAIL IN SHSM BOOK	SIGN DETAIL DETAIL ON SHEET NUMBER	SIGN DETAIL STD. SHEET NUMBER
U.S. ROUTE 2 SOUTH BURLINGTON																																						
53+60, ℄	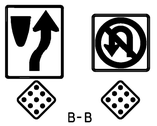 B-B	1 1 1 1	24 36 18 18	30 36 18 18	5.00 9.00 2.25 2.25						1					15' ~~*~~		X	1															R4-7 R3-4 OMI-1 OMI-1	X X X X		
53+70, RT		1 1	42 42	12 12	3.50 3.50						1					11' ~~*~~		X																INSTALL STREET SIGNS 90 DEGREES TO EACH OTHER		89 88	
53+77, RT		1 1	9 9	15 15	0.94 0.94																													R10-3e MOUNT 90 DEGREES TO EACH OTHER ON SIGNAL POLE USING NEW MOUNTING HARDWARE (INCIDENTAL TO SIGN) R10-3e	X X		
53+85, LT		1 1 1 1 1 1	24 24 21 24 30 21	12 24 15 12 24 15	2.00 4.00 2.19 2.00 5.00 2.19						1										23'*1.7 ~~*~~ 39.1 LBS														M3-4 M1-4 M6-3 BLACK ON WHITE M3-3 GREEN ON WHITE M1-5 GREEN ON WHITE M6-1 GREEN ON WHITE	X X X		 E-136B E-136B E-136B
54+03, ℄	B-B	1 1 1	24 18 18	30 18 18	5.00 2.25 2.25						1					14' ~~*~~		X	1															R4-7 OMI-1 OMI-1	X X X		
54+11, RT		1 1	24 24	12 24	2.00 4.00						1					14' ~~*~~		X																M3-2 M1-4	X X		
											FT	FT	FT	FT	FT ~~60~~ 54	FT		EA 2	LB	LB ~~36~~ 39.1	LB		LB	LB	LB	LB										
FINAL POST LENGTHS ARE TO BE DETERMINED IN THE FIELD. POST SIZES ARE COMPUTED BASED ON INFORMATION FURNISHED ON THE STANDARD SHEETS AND THE VTRANS "SIGN POST DESIGN GUIDELINE."		**TOTALS**	SF 60.26	SF	EA.	SF			FT			FT			FT ~~60~~ 54				LB ~~36~~ 39.1			EA.	LB				EA.	EA.	LB							

PROJECT NAME: BURLINGTON-SOUTH BURLINGTON
PROJECT NUMBER: NH 2624(1)

FILE NAME: p06d216.dgn
PROJECT LEADER: JLL
DESIGNED BY: STANTEC
IPARM FILE: p06d216tss25.i

PLOT DATE: 2/7/2012
DRAWN BY: STANTEC
CHECKED BY: STANTEC
SHEET 78 OF 108