STATE OF VERMONT
AGENCY OF TRANSPORTATION

TRAFFIC SIGN SUMMARY SHEET 33

MILEMARKER, STATION, OR SIGN NUMBER	SIGN LEGEND	SIGN DIMENSIONS EA	WIDTH (in)	HEIGHT (in)	NEW & SALVAGED SIGNS "A"	"B"	SALV SIGN	SALV TIS	EXIST POST RETAIN	SALVAGE	NEW SIGN POSTS NO. OF POSTS	FLANGED CHANNEL lb/ft 1.12	2.0	3.0	SQUARE STEEL (in) lb/ft 1.75	2.0	2.5	ANCHOR	SLEEVE	TUBULAR ALUMINUM Ø (in) lb/ft 3.0	4.0	4.0 MOD	TUBULAR STEEL Ø (in) FOUND-ATION	lb/ft 3.0	3.5	4.0	5.0	W-SHAPE STEEL FTG. SIZE 24"	30"	WEIGHT	POST SIZE	SIGNS FRAME REQUIRED	REMARKS	SIGN DETAIL DETAIL IN SHSM BOOK	DETAIL ON SHEET NUMBER	STD. SHEET NUMBER
												1.88	2.42	3.35						1.3	1.7	1.7		7.6	9.0	10.8	14.6									
114+66, LT	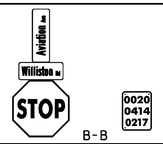	1	42	12	3.50												14'															INSTALL STREET SIGNS 90 DEGREES TO EACH OTHER		89	
		1	42	12	3.50						1						X	X																88	
		1	30	30	6.25																											RI-1	X		
		1	6	10	0.42																														E-138
115+00, RT		1	36	36	9.00						2					28' X		X														W4-2	X		
115+10, LT	B-B	1	24	30	5.00						1					13' X		X														R4-7	X		
		1	18	18	2.25																											OMI-1	X		
		1	18	18	2.25																											OMI-1	X		
119+97, RT		1	30	30	6.25		1				1					13' X		X														W14-2	X		
120+46, RT	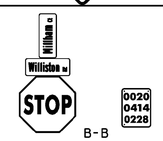	1	36	12	3.00												12.5'															INSTALL STREET SIGNS 90 DEGREES TO EACH OTHER		89	
		1	42	12	3.50						1						X	X																88	
		1	30	30	6.25																											RI-1	X		
		1	6	10	0.42																														E-138
121+31, RT		1	24	18	3.00												15'															VR-039			E-141
		1	30	36	7.50						1						X	X														R2-1	X		
		1	6	10	0.42																														E-138
121+31, LT		1	24	18	3.00												15'															VR-038			E-141
		1	30	36	7.50						1						X	X														R2-1	X		
												FT	FT	FT	FT	FT ~~61~~ 54	FT ~~62~~ 56.5		EA	LB	LB	LB		LB	LB	LB	LB								
FINAL POST LENGTHS ARE TO BE DETERMINED IN THE FIELD. POST SIZES ARE COMPUTED BASED ON INFORMATION FURNISHED ON THE STANDARD SHEETS AND THE VTRANS "SIGN POST DESIGN GUIDELINE."		TOTALS	SF 73.01	SF	EA.	SF						FT			FT ~~123~~ 110.5					LB				EA.	LB				EA.	EA.	LB					

Stantec

PROJECT NAME: BURLINGTON-SOUTH BURLINGTON
PROJECT NUMBER: NH 2624(1)

FILE NAME: p06d216.dgn
PROJECT LEADER: JLL
DESIGNED BY: STANTEC
IPARM FILE: p06d216tss33.i

PLOT DATE: 2/7/2012
DRAWN BY: STANTEC
CHECKED BY: STANTEC
SHEET 86 OF 108