B. R. I.
RENAUD BROS. INC.
STEEL SALES & FABRICATION
VERNON VT. USA
283 FT. BRIDGMAN RD. VERNON VT., 05354
PH. (802) 257-7383 FAX:(802) 257-7308

JOB NAME: PERU
JOB # STP SCRP(4)
DRAWN BY: A.D.
DATE: 6/14/17 DATE DUE:
SHEET 1 OF 1

HEADWALL SECTION
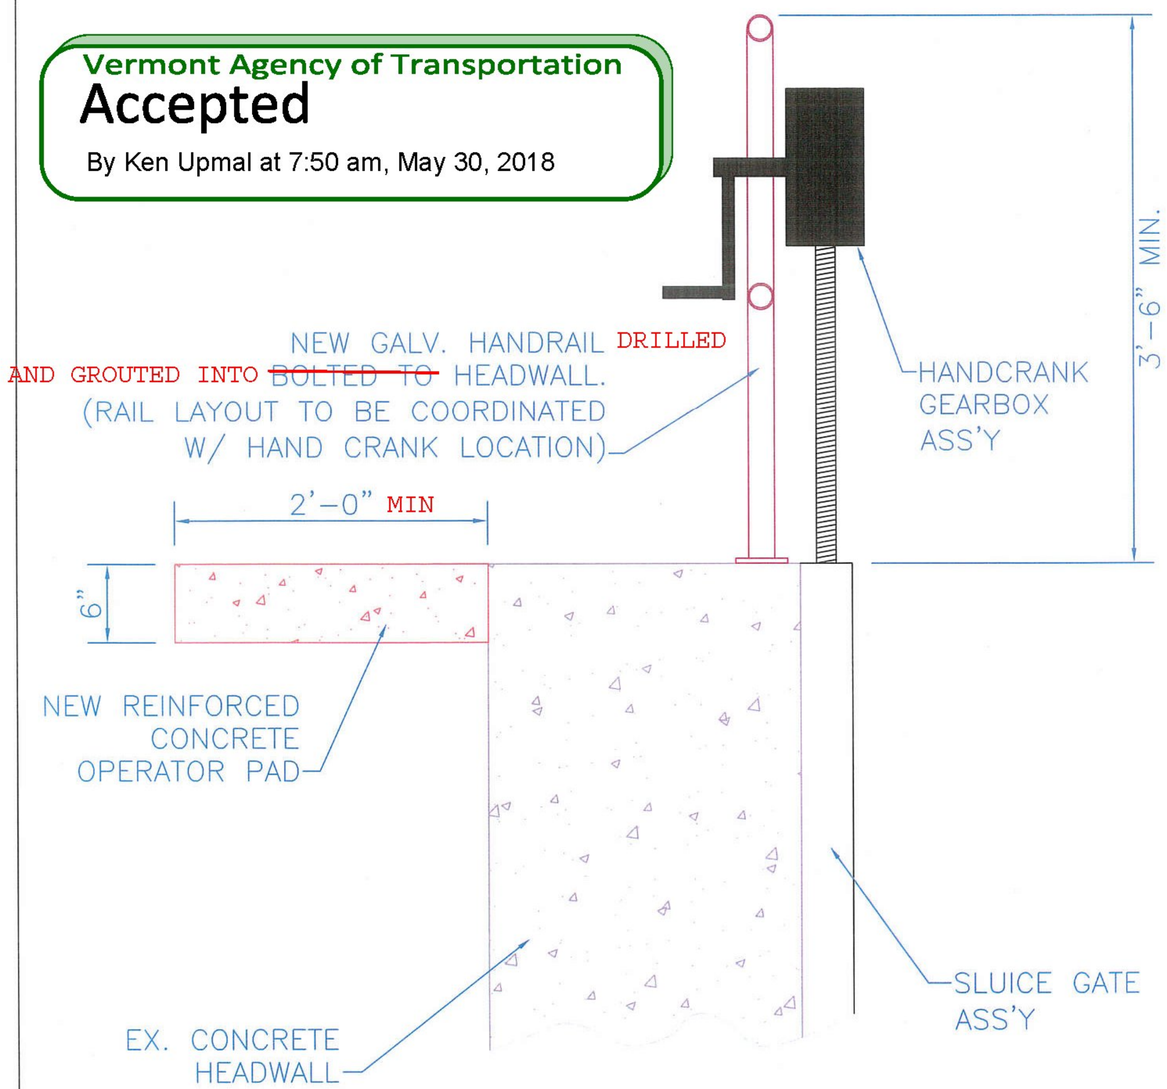
Vermont Agency of Transportation
Accepted
By Ken Upmal at 7:50 am, May 30, 2018