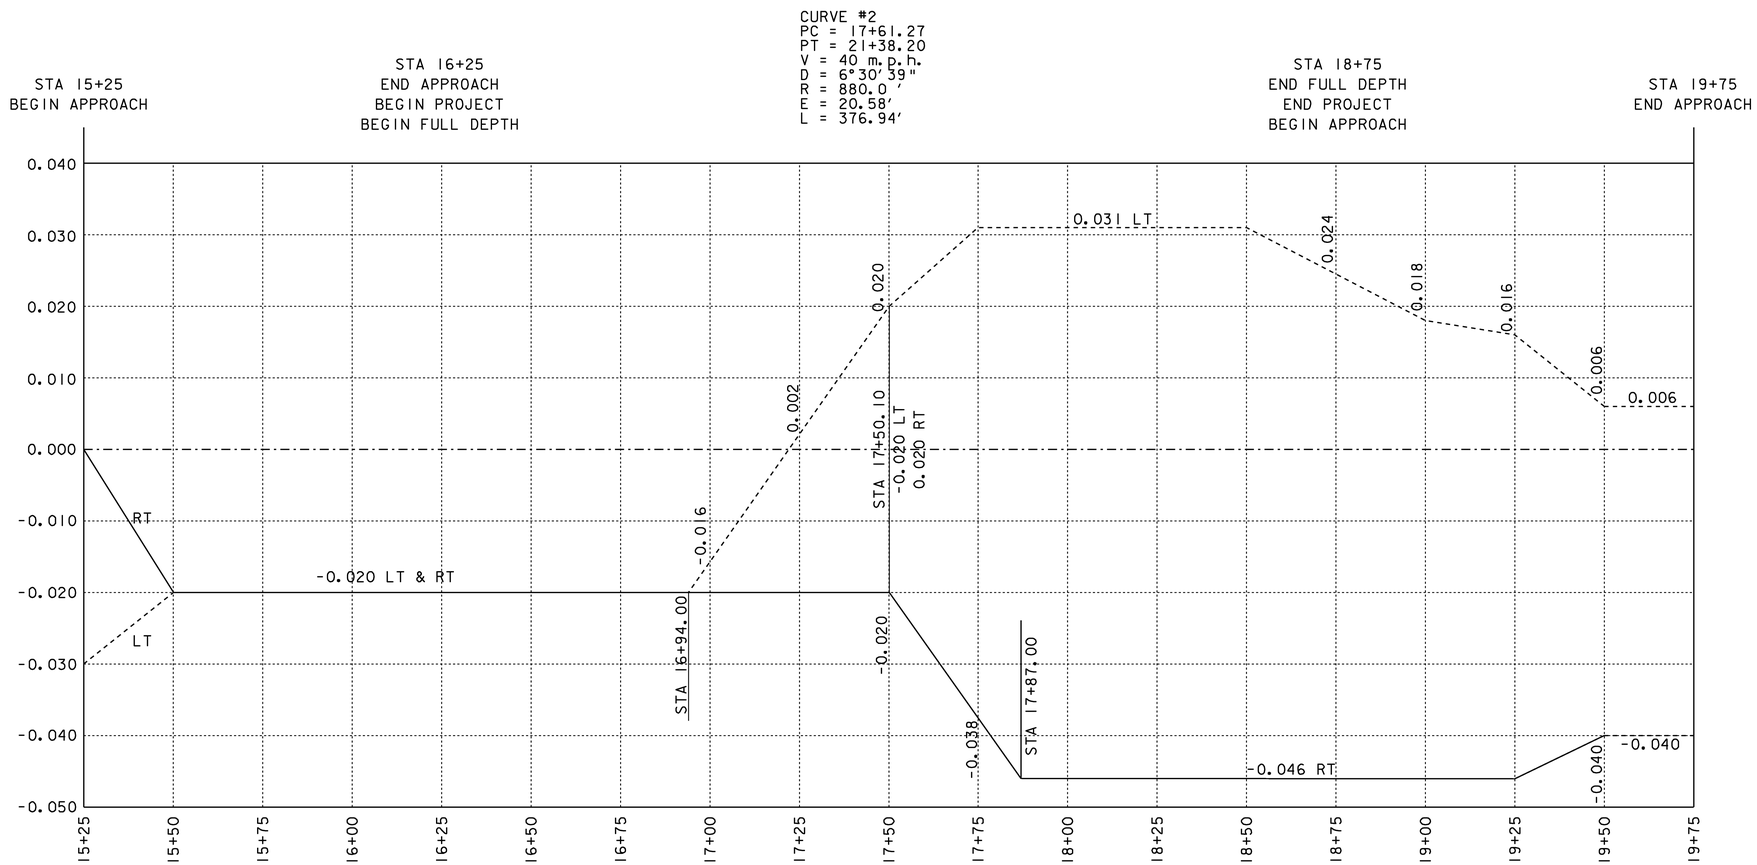

BANKING

PROJECT NAME: CAMBRIDGE	
PROJECT NUMBER: STP 0235(9)	
FILE NAME: D07C152WRK.DGN	PLOT DATE: 28-JUL-2009
PROJECT LEADER: K. ROBIE	DRAWN BY: N. PAPPAS
DESIGNED BY: N. PAPPAS	CHECKED BY: S. MENARD
IPARM: d07x152_banking	SHEET 15 OF 28