STATE OF VERMONT
AGENCY OF TRANSPORTATION

TRAFFIC SIGN SUMMARY SHEET #10

SHS = FHWA STANDARD HIGHWAY SIGNS BOOK

MILEMARKER, STATION, OR SIGN NUMBER	SIGN LEGEND	SIGN DIMENSIONS EA	WIDTH (in)	HEIGHT (in)	NEW & SALVAGED SIGNS "A"	"B"	SALV SIGN	SALV TIS	EXIST POST RETAIN	SALVAGE	NEW SIGN POSTS NO. OF POSTS	SQUARE STEEL (in) 1.75 (1.88 lb/ft)	2.0 (2.42 lb/ft)	2.5 (3.35 lb/ft)	ANCHOR	SLEEVE	TUBULAR ALUMINUM Ø (in) 3.0 (1.3 lb/ft)	4.0 (1.7 lb/ft)	4.0 MOD (1.7 lb/ft)	TUBULAR STEEL Ø (in) FOUND-ATION	3.0 (7.6 lb/ft)	3.5 (9.0 lb/ft)	4.0 (10.8 lb/ft)	5.0 (14.6 lb/ft)	W-SHAPE STEEL FTG. SIZE 24"	30"	WEIGHT	POST SIZE	SIGN FRAME REQUIRED	REMARKS	SIGN DETAIL DETAIL ON SHEET NUMBER	STD. SHEET NUMBER
316+20 LT		1	30	30	6.25						1		X		X															WI-2R		SHS
319+00 RT		1	30	18	3.75						1		X		X																93	
321+63 RT		1	30	36	7.50						1		X		X															R2-1	93	
321+82 LT		1	24	30	5.00						1		X		X															R2-1		SHS
324+00 LT		1	24	12	2.00						1		X		X															M3-3 BLACK ON WHITE		SHS
		1	24	24	4.00																									M1-4		SHS
324+00 RT		1	36	36	9.00						2		X		X															W1-1MeR	93	
		1	18	18	2.25																									W13-1		SHS
325+75 LT	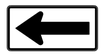	1	48	24	8.00						2		X		X															W1-6L		SHS
325+81 LT	MELENDY HILL RD						1				1		X		X																	
	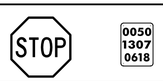	1 1	30 6	30 10	6.25 ~~0.42~~ 0.33																									R1-1 VD-700 BACK TO BACK		SHS E-138
326+02 RT		1	24	30	5.00						1		X		X															VR-017		E-141
							1																									
												FT 0	FT 165	FT		EA	LB	LB	LB		LB	LB	LB	LB								
SHEET TOTALS					SF ~~59.42~~ 59.33	SF	EA. 2	EA.				FT 165					LB			EA.	LB				EA.	EA.	LB					

FINAL POST LENGTHS ARE TO BE DETERMINED IN THE FIELD. POST SIZES ARE COMPUTED BASED ON INFORMATION FURNISHED ON THE STANDARD SHEETS AND VTRANS "SIGN POST DESIGN GUIDELINE."

TRAFFIC SIGN SUMMARY SHEET #10

PROJECT NAME: GUILFORD-BRATTLEBORO
PROJECT NUMBER: STP 2707(1)

FILE NAME: /pave/07c166/pc166
PROJECT LEADER: PTS
DESIGNED BY: DAM
IPARM FILE NAME: 07C166_81

PLOT DATE: 29-JAN-2013 11:42
DRAWN BY: HJD
CHECKED BY: PTS
SHEET 81 OF 97