DURABLE 4 INCH WHITE LINE (SEE OPTION ITEMS)
STA. 269+75 - STA. 275+75 (SOLID LT & RT)

DURABLE 4 INCH YELLOW LINE (SEE OPTION ITEMS)
STA. 269+75 - STA. 275+75 (DASHED)

TEMPORARY 4 INCH WHITE LINE, PAINT
STA. 269+75 - STA. 275+75 (SOLID LT & RT)

TEMPORARY 4 INCH YELLOW LINE, PAINT
STA. 269+75 - STA. 275+75 (DASHED)

REMOVING SIGNS
AS SHOWN - 1

6 INCH UNDERDRAIN PIPE
STA. 269+75 - STA. ~~270+00 LT~~ 270+02 LT

REMOVE AND RESET GUARDRAIL (DOUBLE-SIDED)
STA. 269+75 - STA. 275+75 RT

N
VT STATE PLANE GRID

CURVE #39
DELTA = 0°03'31"
D = 0°06'53"
R = 50000.00'
T = 25.60'
L = 51.19'
E = 0.01'
BANKING NORMAL CROWN
DESIGN SPEED 50 MPH
SEE SUPERELEVATION DIAGRAMS
FOR MORE INFORMATION

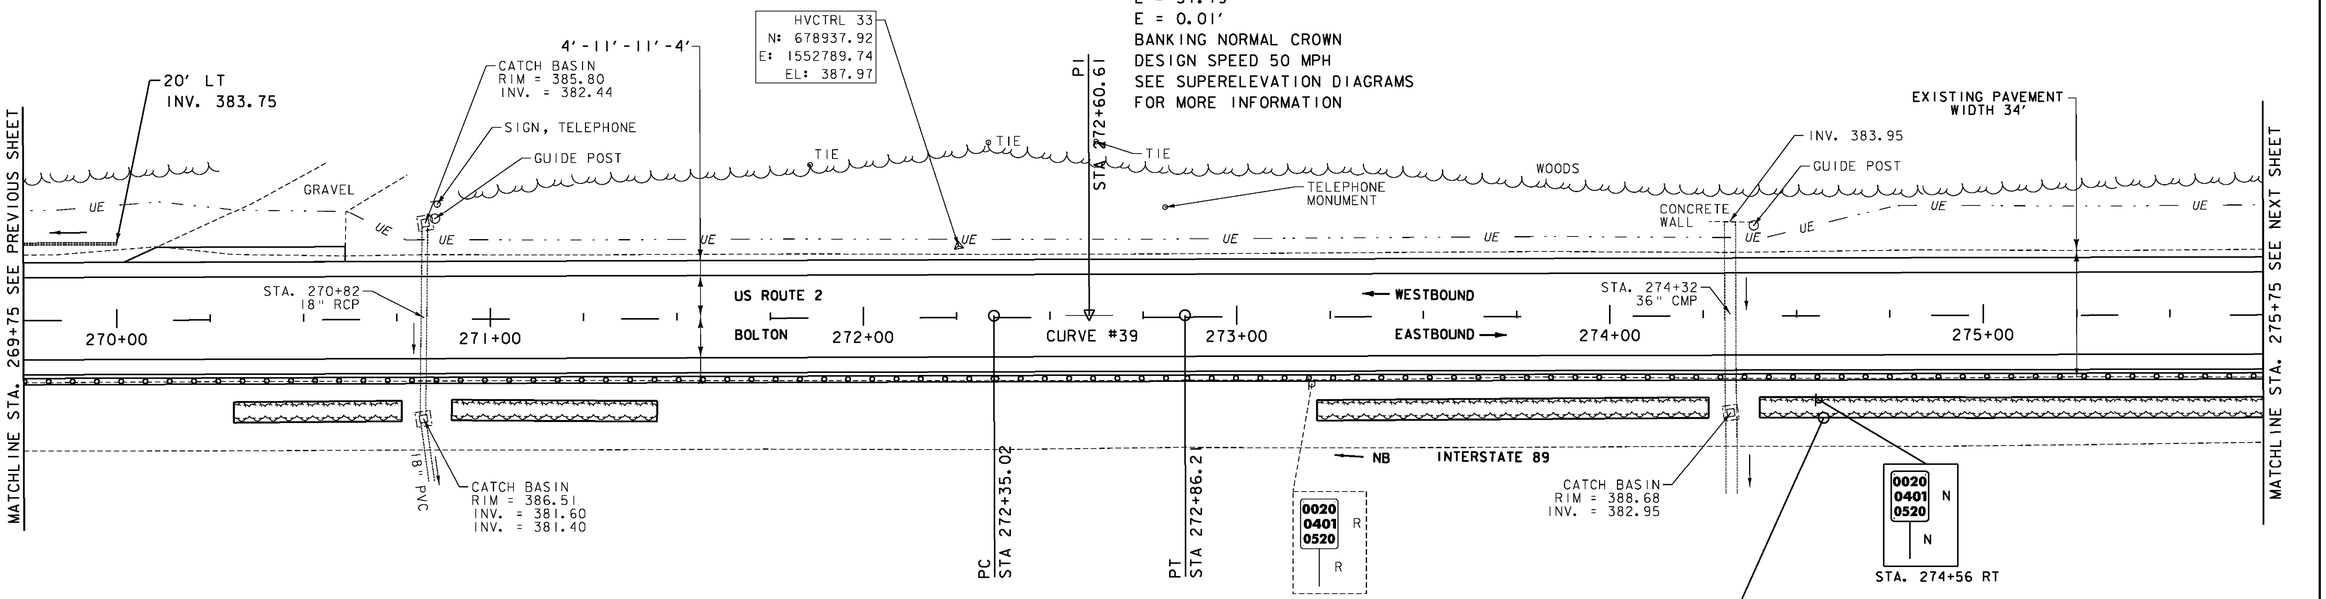

CONTRACTOR TO INSTALL TREE PROTECTION FENCE AROUND EXISTING TREE SCREENING PLANTING BEDS OR AS DIRECTED BY THE RESIDENT ENGINEER (TYP.).
PAY ITEM 656.85 "TREE PROTECTION"

LEGEND
- MAILBOX
- BORING
- SIGN
- HYDRANT
- MANHOLE
- WATER SHUT OFF (WSO)
- GAS PIPELINE MARKER
- CATCH BASIN / DROP INLET
- CURB INLET
- TRAFFIC CONTROL BOX
- PARKING METER
- UTILITY POLE

SIGN LEGEND
R = REMOVE
R&S = REMOVE AND SALVAGE
RET = RETAIN
S = SALVAGE
N = NEW
B-B = BACK TO BACK
—— = EXISTING
—— = NEW

DATUM
VERTICAL NAVD 88
HORIZONTAL NAD 83

SCALE IN FEET
20 0 20

PROJECT LAYOUT SHEET 31

PROJECT NAME: BOLTON - WATERBURY
PROJECT NUMBER: STP 2709(1)

FILE NAME: p07c172.dgn
PROJECT LEADER: CDL
DESIGNED BY: BMB
PLOT FILE: p07c172_55.i
PLOT DATE: 4/16/2013
DRAWN BY: JBG/BMB
CHECKED BY: CDL
SHEET 55 OF 217