DURABLE 4 INCH WHITE LINE (SEE OPTION ITEMS)
STA. A 63+75 - STA. A 69+75 (SOLID LT & RT)

DURABLE 4 INCH YELLOW LINE (SEE OPTION ITEMS)
STA. A 63+75 - STA. A 69+75 (SOLID LT & RT)

TEMPORARY 4 INCH WHITE LINE, PAINT
STA. A 63+75 - STA. A 69+75 (SOLID LT & RT)

TEMPORARY 4 INCH YELLOW LINE, PAINT
STA. A 63+75 - STA. A 69+75 (SOLID LT & RT)

REMOVE AND RESET GUARDRAIL
STA. A 63+75 - STA. A 68+00 RT

STEEL BEAM GUARDRAIL, GALVANIZED W/8 FEET POSTS
STA. A 68+00 - STA. A 68+12.5 RT

REMOVAL AND DISPOSAL OF GUARDRAIL
STA. A 68+00 - STA. A 68+12.5 RT

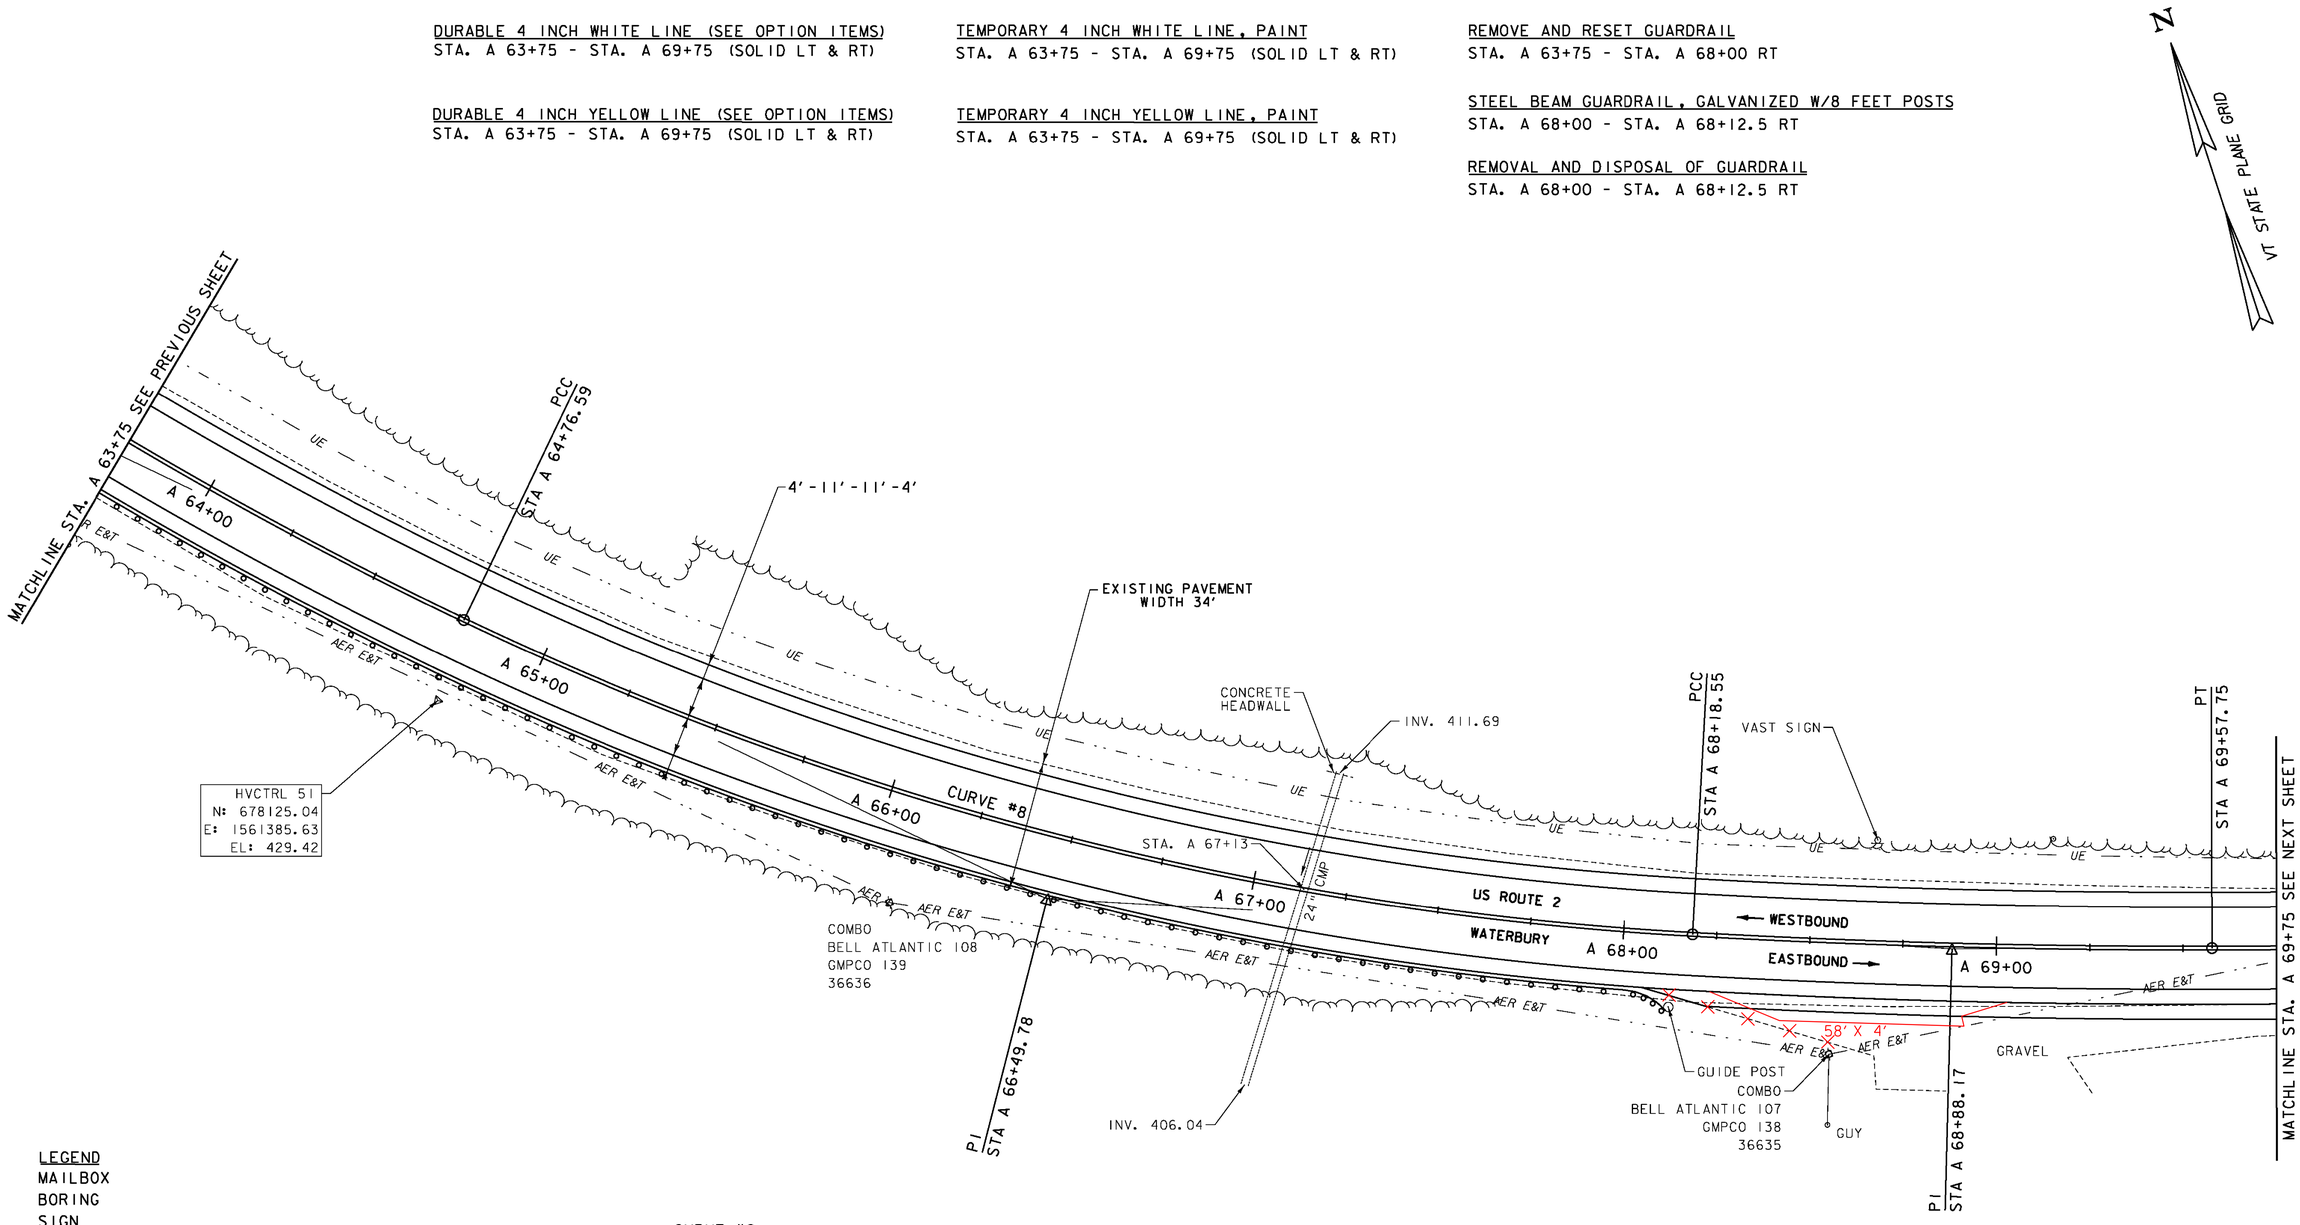

LEGEND
- MAILBOX
- BORING
- SIGN
- HYDRANT
- MANHOLE
- WATER SHUT OFF (WSO)
- GAS PIPELINE MARKER
- CATCH BASIN / DROP INLET
- CURB INLET
- TRAFFIC CONTROL BOX
- PARKING METER
- UTILITY POLE

DATUM
VERTICAL NAVD 88
HORIZONTAL NAD 83

SIGN LEGEND
- R = REMOVE
- R&S = REMOVE AND SALVAGE
- RET = RETAIN
- S = SALVAGE
- N = NEW
- B-B = BACK TO BACK
- —— = EXISTING
- —— = NEW

CURVE #8
DELTA = 36°37'33"
D = 5°00'14"(1) D = 6°32'53"(2) D = 2°23'32"(3)
R = 1145.00' (1) R = 875.00' (2) R = 2395.00' (3)
T = 338.42' (1) T = 382.61' (2)
L = 217.91' (1) L = 341.96' (2) L = 139.20' (3)
E = 48.96'
BANKING 0.071 FT/FT, 0.078 FT/FT, 0.044 FT/FT
DESIGN SPEED 50 MPH
SEE SUPERELEVATION DIAGRAMS
FOR MORE INFORMATION

SCALE IN FEET
20 0 20

PROJECT LAYOUT SHEET 47

PROJECT NAME: BOLTON - WATERBURY
PROJECT NUMBER: STP 2709(1)

FILE NAME: p07c172.dgn
PROJECT LEADER: CDL
DESIGNED BY: BMB
PLOT FILE: p07c172_71.i
PLOT DATE: 4/16/2013
DRAWN BY: JBG/BMB
CHECKED BY: CDL
SHEET 71 OF 217