TEMPORARY 4 INCH WHITE LINE, PAINT
DURABLE 4 INCH WHITE LINE (OPTION BID ITEM)
(ALL LINES WILL INCLUDE EDGE LINE BREAKS AND RADII FOR SIDE ROADS)
STA. 20+00 TO 25+00, SOLID LT & RT

TEMPORARY 4 INCH YELLOW LINE, PAINT
DURABLE 4 INCH YELLOW LINE (OPTION BID ITEM)
(ALL LINES WILL INCLUDE ℄ BREAKS FOR SIDE ROADS)
STA. 20+00 TO 25+00, SOLID LT & RT

REMOVING SIGNS
AS SHOWN - 1

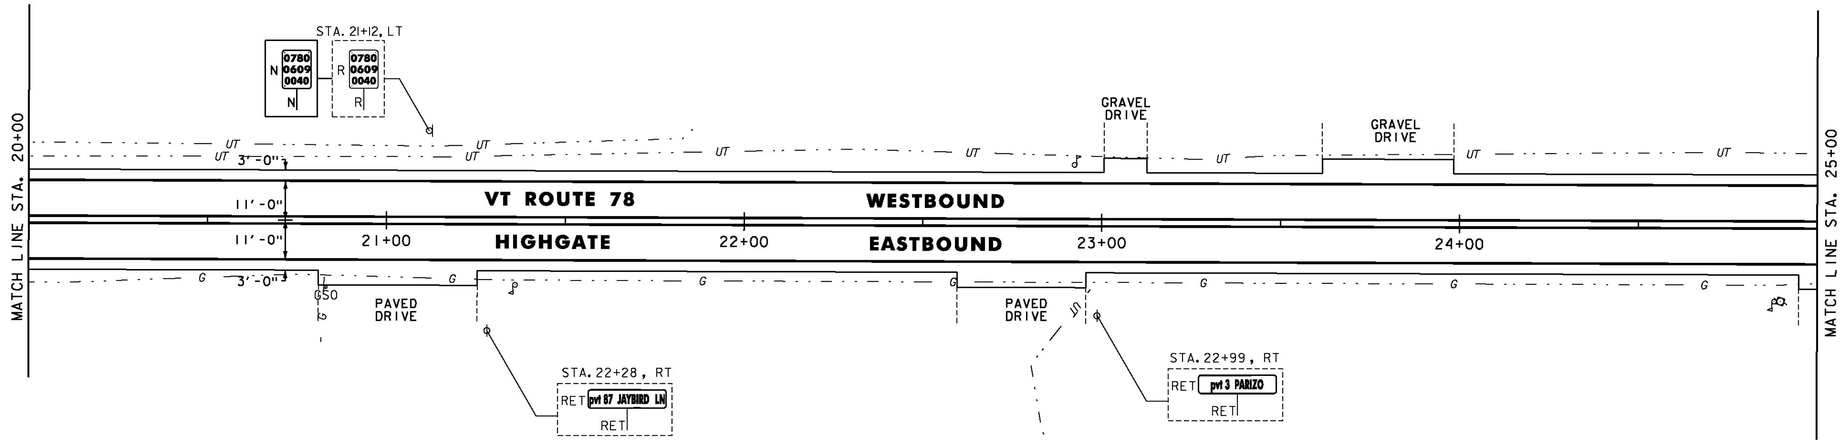

TEMPORARY 4 INCH WHITE LINE, PAINT
DURABLE 4 INCH WHITE LINE (OPTION BID ITEM)
(ALL LINES WILL INCLUDE EDGE LINE BREAKS AND RADII FOR SIDE ROADS)
STA. 25+00 TO 30+00, SOLID LT & RT
STA. 27+81, SOLID LT (EDGELINES, AIRPORT ROAD)

TEMPORARY 4 INCH YELLOW LINE, PAINT
DURABLE 4 INCH YELLOW LINE (OPTION BID ITEM)
(ALL LINES WILL INCLUDE ℄ BREAKS FOR SIDE ROADS)
STA. 25+00 TO 28+51, SOLID LT & RT
STA. 27+81, DOUBLE SOLID LT (AIRPORT ROAD)
STA. 28+51 TO 30+00, SOLID LT, DASHED RT

TEMPORARY 24 INCH STOP BAR, PAINT
DURABLE 24 INCH STOP BAR (OPTION BID ITEM)
STA. 27+81, LT (AIRPORT ROAD)

TEMPORARY LETTER OR SYMBOL, PAINT
DURABLE LETTER OR SYMBOL (OPTION BID ITEM)
STA. 27+81, LT "STOP" (AIRPORT ROAD)

REMOVING SIGNS
AS SHOWN - 4

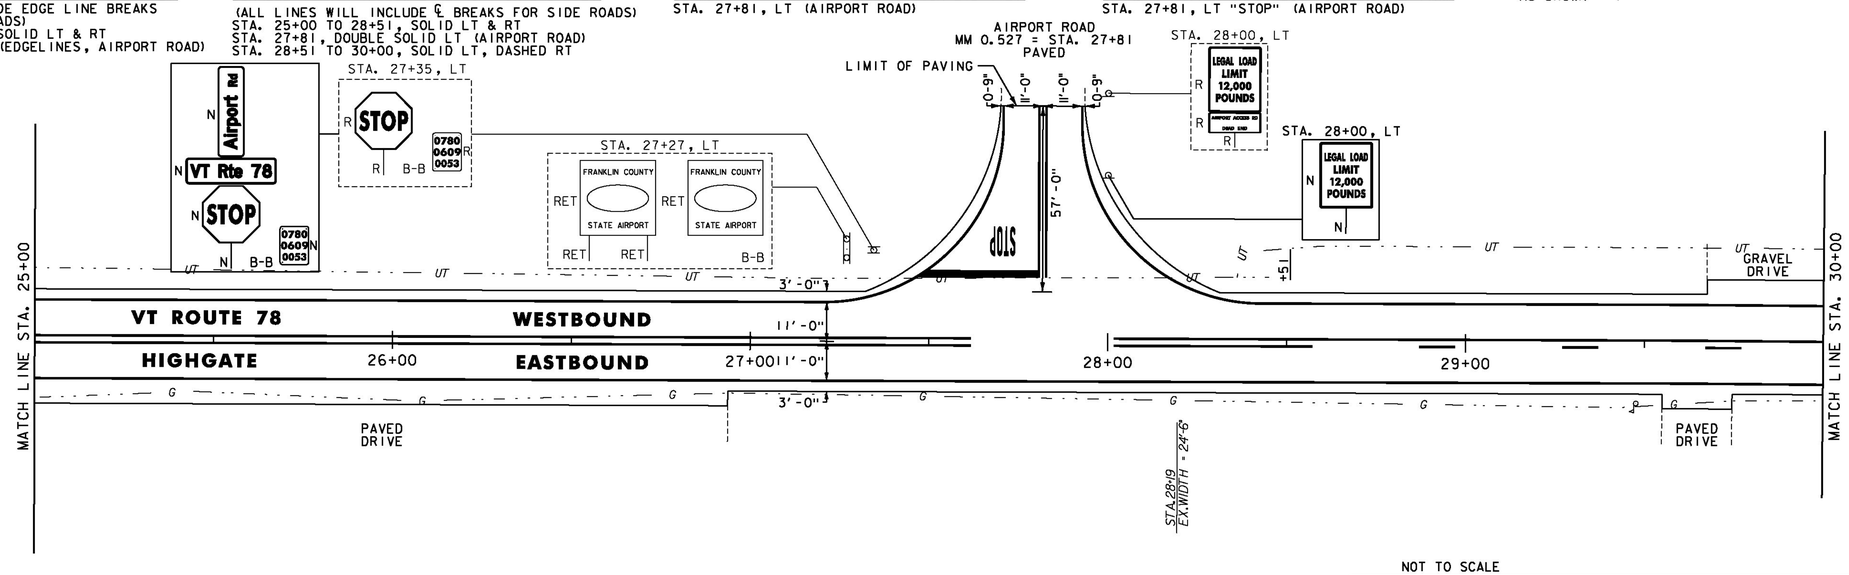

NOTES:

1. FOR LEGENDS, SEE SHEET 19.
2. ALL EXISTING SIGNS NOT SHOWN SHALL BE RETAINED.
3. ALL UTILITY LOCATIONS SHOWN ARE APPROXIMATE AND SHOULD BE VERIFIED PRIOR TO ANY WORK COMMENCING.

Stantec

NOT TO SCALE

PROJECT LAYOUT SHEET #11

PROJECT NAME: SWANTON-SHELDON
PROJECT NUMBER: STP 2715(1)

FILE NAME: p07c186.dgn
PROJECT LEADER: G. EDWARDS
DESIGNED BY: G. BARRETT
PLOT DATE: 4/24/2014
DRAWN BY: G. BARRETT
CHECKED BY: M. FOISY
SHEET 29 OF 121