MILLED RUMBLE STRIPS
~~STA. 44+35 TO 45+00, ℄~~

TEMPORARY 4 INCH WHITE LINE, PAINT
DURABLE 4 INCH WHITE LINE (OPTION BID ITEM)
(ALL LINES WILL INCLUDE EDGE LINE BREAKS AND RADII FOR SIDE ROADS)
STA. 40+00 TO 45+00, SOLID LT & RT

TEMPORARY 4 INCH YELLOW LINE, PAINT
DURABLE 4 INCH YELLOW LINE (OPTION BID ITEM)
(ALL LINES WILL INCLUDE ℄ BREAKS FOR SIDE ROADS)
STA. 40+00 TO 43+30, DASHED LT, SOLID RT
STA. 43+30 TO 45+00, SOLID LT & RT

REMOVING SIGNS
AS SHOWN - 1

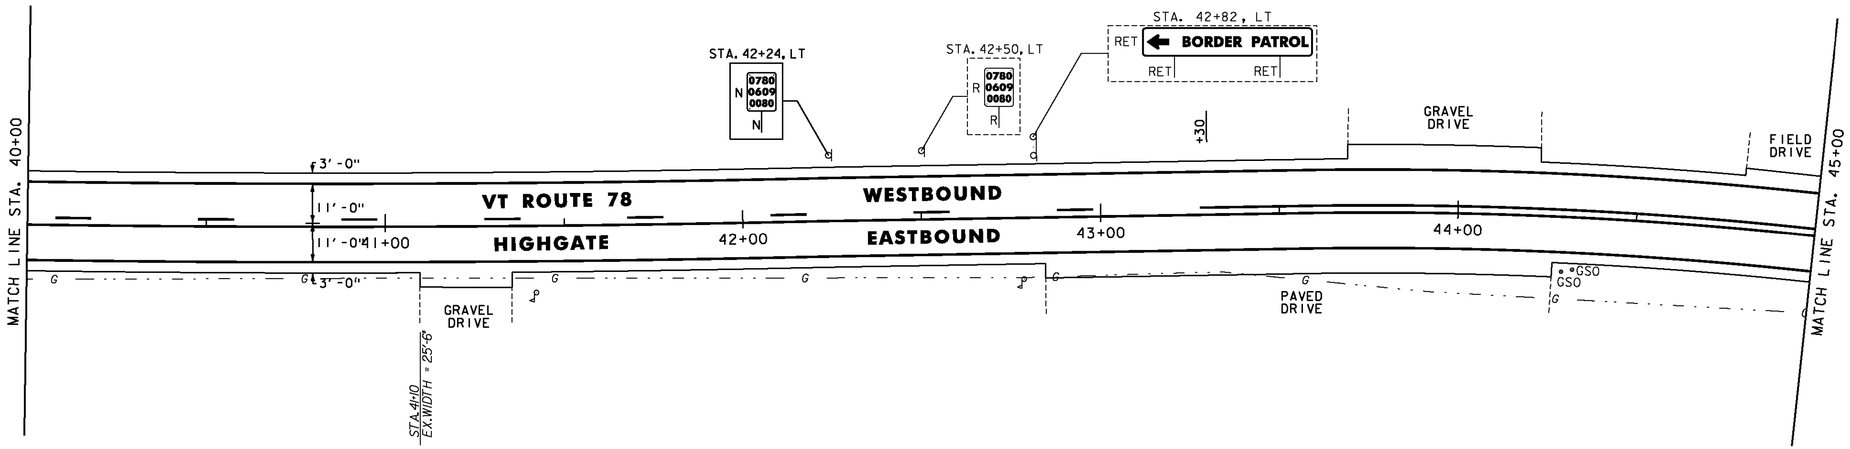

MILLED RUMBLE STRIPS
STA. ~~45+00~~ 46+15 TO 50+00, ℄

TEMPORARY 4 INCH WHITE LINE, PAINT
DURABLE 4 INCH WHITE LINE (OPTION BID ITEM)
(ALL LINES WILL INCLUDE EDGE LINE BREAKS AND RADII FOR SIDE ROADS)
STA. 45+00 TO 50+00, SOLID LT & RT

TEMPORARY 4 INCH YELLOW LINE, PAINT
DURABLE 4 INCH YELLOW LINE (OPTION BID ITEM)
(ALL LINES WILL INCLUDE ℄ BREAKS FOR SIDE ROADS)
STA. 45+00 TO 50+00, SOLID LT & RT

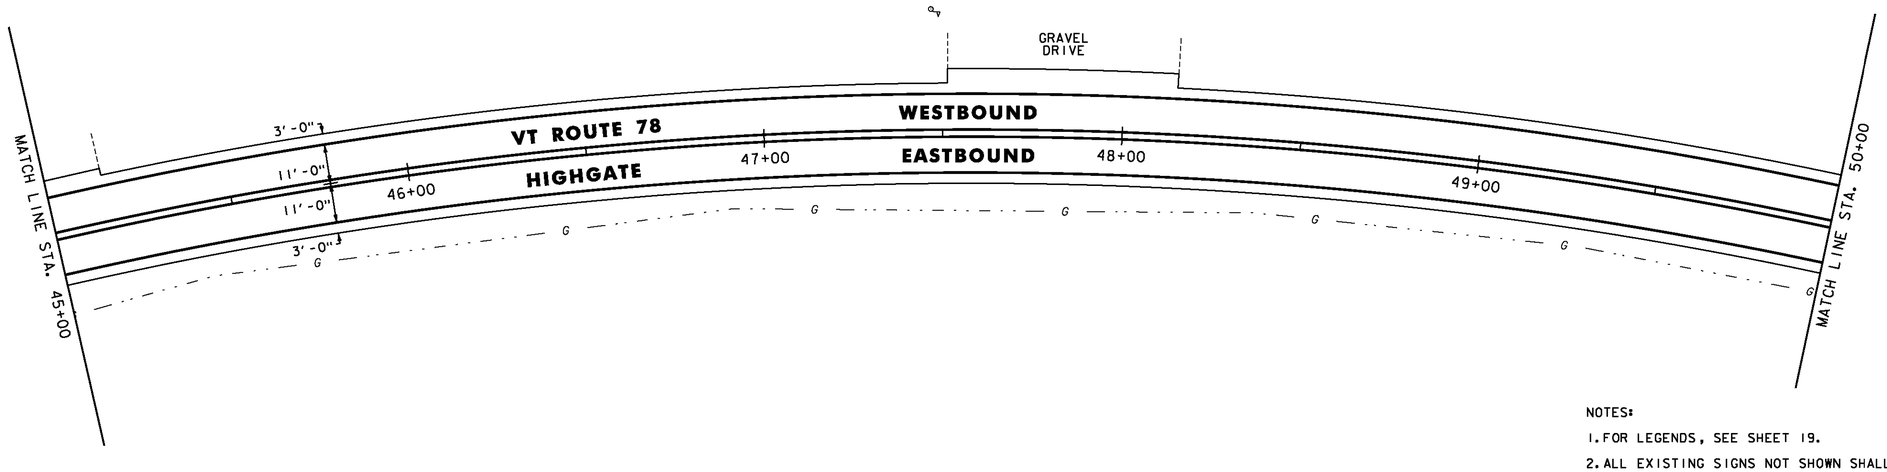

NOTES:

1. FOR LEGENDS, SEE SHEET 19.
2. ALL EXISTING SIGNS NOT SHOWN SHALL BE RETAINED.
3. ALL UTILITY LOCATIONS SHOWN ARE APPROXIMATE AND SHOULD BE VERIFIED PRIOR TO ANY WORK COMMENCING.

NOT TO SCALE

Stantec

PROJECT LAYOUT SHEET #13

PROJECT NAME: SWANTON-SHELDON
PROJECT NUMBER: STP 2715(1)

FILE NAME: p07c186.dgn
PROJECT LEADER: G. EDWARDS
DESIGNED BY: G. BARRETT
PLOT DATE: 4/24/2014
DRAWN BY: G. BARRETT
CHECKED BY: M. FOISY
SHEET 31 OF 121