STATE OF VERMONT
AGENCY OF TRANSPORTATION

TRAFFIC SIGN SUMMARY SHEET 02

MILEMARKER, STATION, OR SIGN NUMBER	SIGN LEGEND	SIGN DIMENSIONS EA	SIGN DIMENSIONS WIDTH (In)	SIGN DIMENSIONS HEIGHT (In)	NEW & SALVAGED SIGNS "A"	NEW & SALVAGED SIGNS "B"	NEW & SALVAGED SIGNS SALV SIGN	NEW & SALVAGED SIGNS SALV TIS	EXIST POST RETAIN	EXIST POST SALVAGE	NEW SIGN POSTS NO. OF POSTS	FLANGED CHANNEL lb/ft 1.12	FLANGED CHANNEL lb/ft 2.0	FLANGED CHANNEL lb/ft 3.0	SQUARE STEEL (In) lb/ft 1.75 (1.88)	SQUARE STEEL (In) lb/ft 2.0 (2.42)	SQUARE STEEL (In) lb/ft 2.5 (3.35)	ANCHOR	SLEEVE	TUBULAR ALUMINUM Ø (In) lb/ft 3.0 (1.3)	TUBULAR ALUMINUM Ø (In) lb/ft 4.0 (1.7)	TUBULAR ALUMINUM Ø (In) lb/ft 4.0 MOD (1.7)	FOUND-ATION	TUBULAR STEEL Ø (In) lb/ft 3.0 (7.6)	TUBULAR STEEL Ø (In) lb/ft 3.5 (9.0)	TUBULAR STEEL Ø (In) lb/ft 4.0 (10.8)	TUBULAR STEEL Ø (In) lb/ft 5.0 (14.6)	W-SHAPE STEEL FTG. SIZE 24"	W-SHAPE STEEL FTG. SIZE 30"	W-SHAPE STEEL WEIGHT	W-SHAPE STEEL POST SIZE	SIGN FRAME REQUIRED	REMARKS	SIGN DETAIL DETAIL IN SHSM * BOOK	SIGN DETAIL DETAIL ON SHEET NUMBER	SIGN DETAIL STD. SHEET NUMBER
SWANTON VT ROUTE 78 (CONT.)																																				
391+25, LT	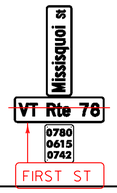	1 1 1	42 42 6	12 12 10	3.50 •3.00 3.50 0.42						1					X 11.0		X															D3-1 D3-1 VD-700		113 113	 E-138
391+77, RT	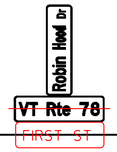	1 1	42 42	12 12	3.50 •3.00 3.50						1					X 10.75		X															D3-1 D3-1		113 113	
392+03, LT		1	9	15	0.94																												R10-3e MOUNT NEW SIGN ON EXISTING PEDESTRIAN SIGNAL POLE USING NEW MOUNTING HARDWARE (INCIDENTAL TO SIGN)	X		
392+10, RT		1	24	30	5.00						1					X 12.5		X															VR-020			E-146
393+18, RT		1	24	30	5.00						1					X 15.25		X															VR-020			E-146
393+96, LT		1	48	30	10.00						2					X 13.5 13.5		X															VR-932			E-145B
395+02, RT		1	24	30	5.00						1					X 15.0		X															VR-020			E-146
395+08, LT							1 1				1						X 14.25	X															D4-2 "1-800" SIGN IS TO BE INSTALLED BELOW THE "PARK & RIDE" SIGN USING VTRANS STANDARD T-45, MOUNTED ON A NEW POST	X		
												FT	FT	FT	FT	FT ~~103~~ 91.5	FT ~~16~~ 14.25		EA	LB	LB	LB		LB	LB	LB	LB								
TOTALS					SF 40.36	SF	EA. 2	SF				FT			FT ~~119~~ 105.75					LB			EA.	LB				EA.	EA.	LB					

* "SHSM"-STANDARD HIGHWAY SIGNS AND MARKINGS

FINAL POST LENGTHS ARE TO BE DETERMINED IN THE FIELD. POST SIZES ARE COMPUTED BASED ON INFORMATION FURNISHED ON THE STANDARD SHEETS AND THE VTRANS "SIGN POST DESIGN GUIDELINE."

TRAFFIC SIGN SUMMARY SHEET #2

PROJECT NAME: SWANTON-SHELDON
PROJECT NUMBER: STP 2715(1)

FILE NAME: p07c186.dgn
PROJECT LEADER: JLL
DESIGNED BY: STANTEC

PLOT DATE: 4/24/2014
DRAWN BY: STANTEC
CHECKED BY: STANTEC
SHEET 85 OF 121