STATE OF VERMONT
AGENCY OF TRANSPORTATION

TRAFFIC SIGN SUMMARY SHEET 05

MILEMARKER, STATION, OR SIGN NUMBER	SIGN LEGEND	SIGN DIMENSIONS EA	WIDTH (in)	HEIGHT (in)	NEW & SALVAGED SIGNS "A"	"B"	SALV SIGN	SALV TIS	EXIST POST RETAIN	SALVAGE	NEW SIGN POSTS NO. OF POSTS	FLANGED CHANNEL lb/ft 1.12	2.0	3.0	SQUARE STEEL (in) lb/ft 1.75 1.88	2.0 2.42	2.5 3.35	ANCHOR	SLEEVE	TUBULAR ALUMINUM Ø (in) lb/ft 3.0 1.3	4.0 1.7	4.0 MOD 1.7	TUBULAR STEEL Ø (in) FOUND-ATION	lb/ft 3.0 7.6	3.5 9.0	4.0 10.8	5.0 14.6	W-SHAPE STEEL FTG. SIZE 24"	30"	WEIGHT	POST SIZE	SIGN FRAME REQUIRED	REMARKS	SIGN DETAIL DETAIL IN SHSM * BOOK	DETAIL ON SHEET NUMBER	STD. SHEET NUMBER
SWANTON VT ROUTE 78 (CONT.)																																				
425+45, RT		1 1	24 24	30 30	5.00 5.00						1						X 15.5	X															R2-1 VR-017	X		 E-141
425+72, RT	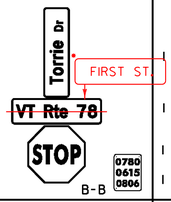	1 1 1 1	42 42 30 6	12 12 30 10	3.50 •3.00 3.50 6.25 0.42						1						X 13.75	X															D3-1 D3-1 R1-1 VD-700	 X 	113 113 	 E-138
425+82, LT		1	30	30	6.25						1					X 13.25		X															R1-1	X		
426+47, LT		1 1 1	30 36 36	30 12 12	6.25 3.00 3.00						1					X 14.0		X															R5-1 R6-1 INSTALL 90 DEGREES TO SIGN R5-1 R6-1 INSTALL 90 DEGREES TO SIGN R5-1	X X X		
429+48, LT		1 1	30 24	36 30	7.50 5.00						1												1	14•7.6= X 110.21 lb									R2-1 R4-1	X X		
429+48, RT		1 1	24 48 X 48 X 36	30 	5.00 5.56						2					16' X 15.75		X															R2-1 W14-3	X X		
429+58.08, RT	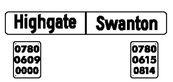	1 1 1	72 6 6	10 10 10	5.00 0.42 0.42						2					14.5 X 14.75		X															VD-024 VD-700 VD-700		119 	 E-138 E-138
TOTALS					SF 71.07	SF	EA.	SF				FT	FT	FT	FT	FT 88	FT 31		EA	LB	LB	LB		LB 84	LB	LB	LB								
												FT				FT ~~119~~ 117.5				LB			EA. 1	LB 84				EA.	EA.	LB					

* "SHSM"-STANDARD HIGHWAY SIGNS AND MARKINGS

FINAL POST LENGTHS ARE TO BE DETERMINED IN THE FIELD. POST SIZES ARE COMPUTED BASED ON INFORMATION FURNISHED ON THE STANDARD SHEETS AND THE VTRANS "SIGN POST DESIGN GUIDELINE."

TRAFFIC SIGN SUMMARY SHEET #5

PROJECT NAME: SWANTON-SHELDON
PROJECT NUMBER: STP 2715(1)

FILE NAME: p07c186.dgn
PROJECT LEADER: JLL
DESIGNED BY: STANTEC

PLOT DATE: 4/24/2014
DRAWN BY: STANTEC
CHECKED BY: STANTEC
SHEET 88 OF 121