STATE OF VERMONT
AGENCY OF TRANSPORTATION

TRAFFIC SIGN SUMMARY SHEET 11

MILEMARKER, STATION, OR SIGN NUMBER	SIGN LEGEND	SIGN DIMENSIONS EA	WIDTH (In)	HEIGHT (In)	NEW & SALVAGED SIGNS "A"	"B"	SALV SIGN	SALV TIS	EXIST POST RETAIN	EXIST POST SALVAGE	NEW SIGN POSTS NO. OF POSTS	FLANGED CHANNEL lb/ft 1.12	2.0	3.0	SQUARE STEEL (In) lb/ft 1.75	2.0	2.5	ANCHOR	SLEEVE	TUBULAR ALUMINUM Ø (In) lb/ft 3.0	4.0	4.0 MOD	TUBULAR STEEL Ø (In) FOUNDATION	lb/ft 3.0	3.5	4.0	5.0	W-SHAPE STEEL FTG. SIZE 24"	30"	WEIGHT	POST SIZE	SIGN FRAME REQUIRED	REMARKS	SIGN DETAIL DETAIL IN SHSM * BOOK	DETAIL ON SHEET NUMBER	STD. SHEET NUMBER
HIGHGATE VT ROUTE 78 (CONT.)																																					
151+66, RT		1	24	12	2.00						2												2	X								*2	M3-2 (GREEN ON WHITE)	X		
		1	24	24	4.00																													(GREEN ON WHITE)			E-136B
		1	21	15	2.19																													M6-3 (GREEN ON WHITE)	X		
		1	24	12	2.00																													M4-5 (BLACK ON WHITE)	X		
		1	24	12	2.00																													M3-1 (BLACK ON WHITE)			
		1	30	24	5.00																													MI-5 (BLACK ON WHITE)	X		
		1	24	12	2.00																													M3-3 (GREEN ON WHITE)	X		
		1	30	24	5.00																													(GREEN ON WHITE)			E-136B
		1	21	15	2.19																													M6-1 (GREEN ON WHITE)	X		
151+75, RT		1	30	30	6.25						1					X 13		X																RI-1	X		
152+35, RT	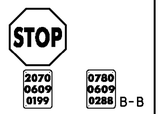	1	30	30	6.25						1					X 14		X																RI-1	X		
		1	6	10	0.42																													VD-700			E-138
		1	6	10	0.42																													VD-700			E-138
153+12, LT		1	24	12	2.00						2					16.5 X 16		X															*2	M3-3 (GREEN ON WHITE)	X		
		1	30	24	5.00																													(GREEN ON WHITE)			E-136B
		1	21	15	2.19																													M6-1 (GREEN ON WHITE)	X		
		1	24	12	2.00																													M3-4 (GREEN ON WHITE)	X		
		1	24	24	4.00																													(GREEN ON WHITE)			E-136B
		1	21	15	2.19																													M6-3 (GREEN ON WHITE)	X		
153+44, RT		1	24	12	2.00						1					X 15.5		X																M3-2 (GREEN ON WHITE)	X		
		1	24	24	4.00																													(GREEN ON WHITE)			E-136B
154+44, RT		1	36	36	9.00						2					16 X 16.75		X																WI-10L VARIATION		118	
		1	42	15	4.38																													WI6-8aP		118	
											FT	FT	FT	FT	FT 82	FT 33		EA	LB	LB	LB		LB 259	LB	LB	LB									
	TOTALS				SF 76.48	SF	EA.	SF			FT				FT ~~115~~ 107.75				LB				EA. 2	LB 259				EA.	EA.	LB						

* "SHSM"-STANDARD HIGHWAY SIGNS AND MARKINGS

FINAL POST LENGTHS ARE TO BE DETERMINED IN THE FIELD. POST SIZES ARE COMPUTED BASED ON INFORMATION FURNISHED ON THE STANDARD SHEETS AND THE VTRANS "SIGN POST DESIGN GUIDELINE."

TRAFFIC SIGN SUMMARY SHEET #11

PROJECT NAME: SWANTON-SHELDON
PROJECT NUMBER: STP 2715(I)

FILE NAME: p07c186.dgn
PROJECT LEADER: JLL
DESIGNED BY: STANTEC
PLOT DATE: 4/24/2014
DRAWN BY: STANTEC
CHECKED BY: STANTEC
SHEET 94 OF 121