604.412, 604.415 OR 604.418 REHAB.
DIs, CBs OR MHs, CLASS I,II OR III
STA. 149+28, RT
STA. 149+62, RT
STA. 151+97, RT
STA. 153+13, RT
STA. 153+67, RT

604.40 CHANGING ELEVATION DI'S, CB'S, & RMH'S

604.42 CHANGING ELEVATION OF SEWER MANHOLES
STA. 153+78, RT

618.10 PORTLAND CEMENT CONCRETE SIDEWALK, 5 INCH
STA. 149+35, RT
STA. 149+70, RT

618.30 DETECTABLE WARNING SURFACE
STA. 149+35, RT
STA. 149+70, RT

621.51 MANUFACTURED TERMINAL SECTION, TANGENT
STA. ~~151+80~~ 151+92.5 TO ~~152+30~~ 152+42.5, RT

621.80 REMOVAL AND DISPOSAL OF GUARDRAIL
~~STA. 151+80~~ STA 151+92.5 TO 152+30, RT

646.402 DURABLE 4 INCH WHITE LINE, THERMOPLASTIC
(ALL LINES WILL INCLUDE EDGE LINE AND LANE LINE BREAKS AND RADII FOR SIDE ROADS)
STA. 149+00 TO 154+00, SOLID LT & RT

646.412 DURABLE 4 INCH YELLOW LINE, THERMOPLASTIC
(ALL LINES WILL INCLUDE ℄ BREAKS FOR SIDE ROADS)
STA. 149+00 TO 154+00, SOLID LT & RT

646.502 DURABLE CROSSWALK MARKING, THERMOPLASTIC
STA. 149+36 TO 149+63, RT

646.602 TEMPORARY 4 INCH WHITE LINE, PAINT
(ALL LINES WILL INCLUDE EDGE LINE AND LANE LINE BREAKS AND RADII FOR SIDE ROADS)
STA. 149+00 TO 154+00, SOLID LT & RT

646.612 TEMPORARY 4 INCH YELLOW LINE, PAINT
(ALL LINES WILL INCLUDE ℄ BREAKS FOR SIDE ROADS)
STA. 149+00 TO 154+00, SOLID LT & RT

646.702 TEMPORARY CROSSWALK MARKING, PAINT
STA. 149+36 TO 149+63, RT

675.50 REMOVING SIGNS
AS SHOWN - 2

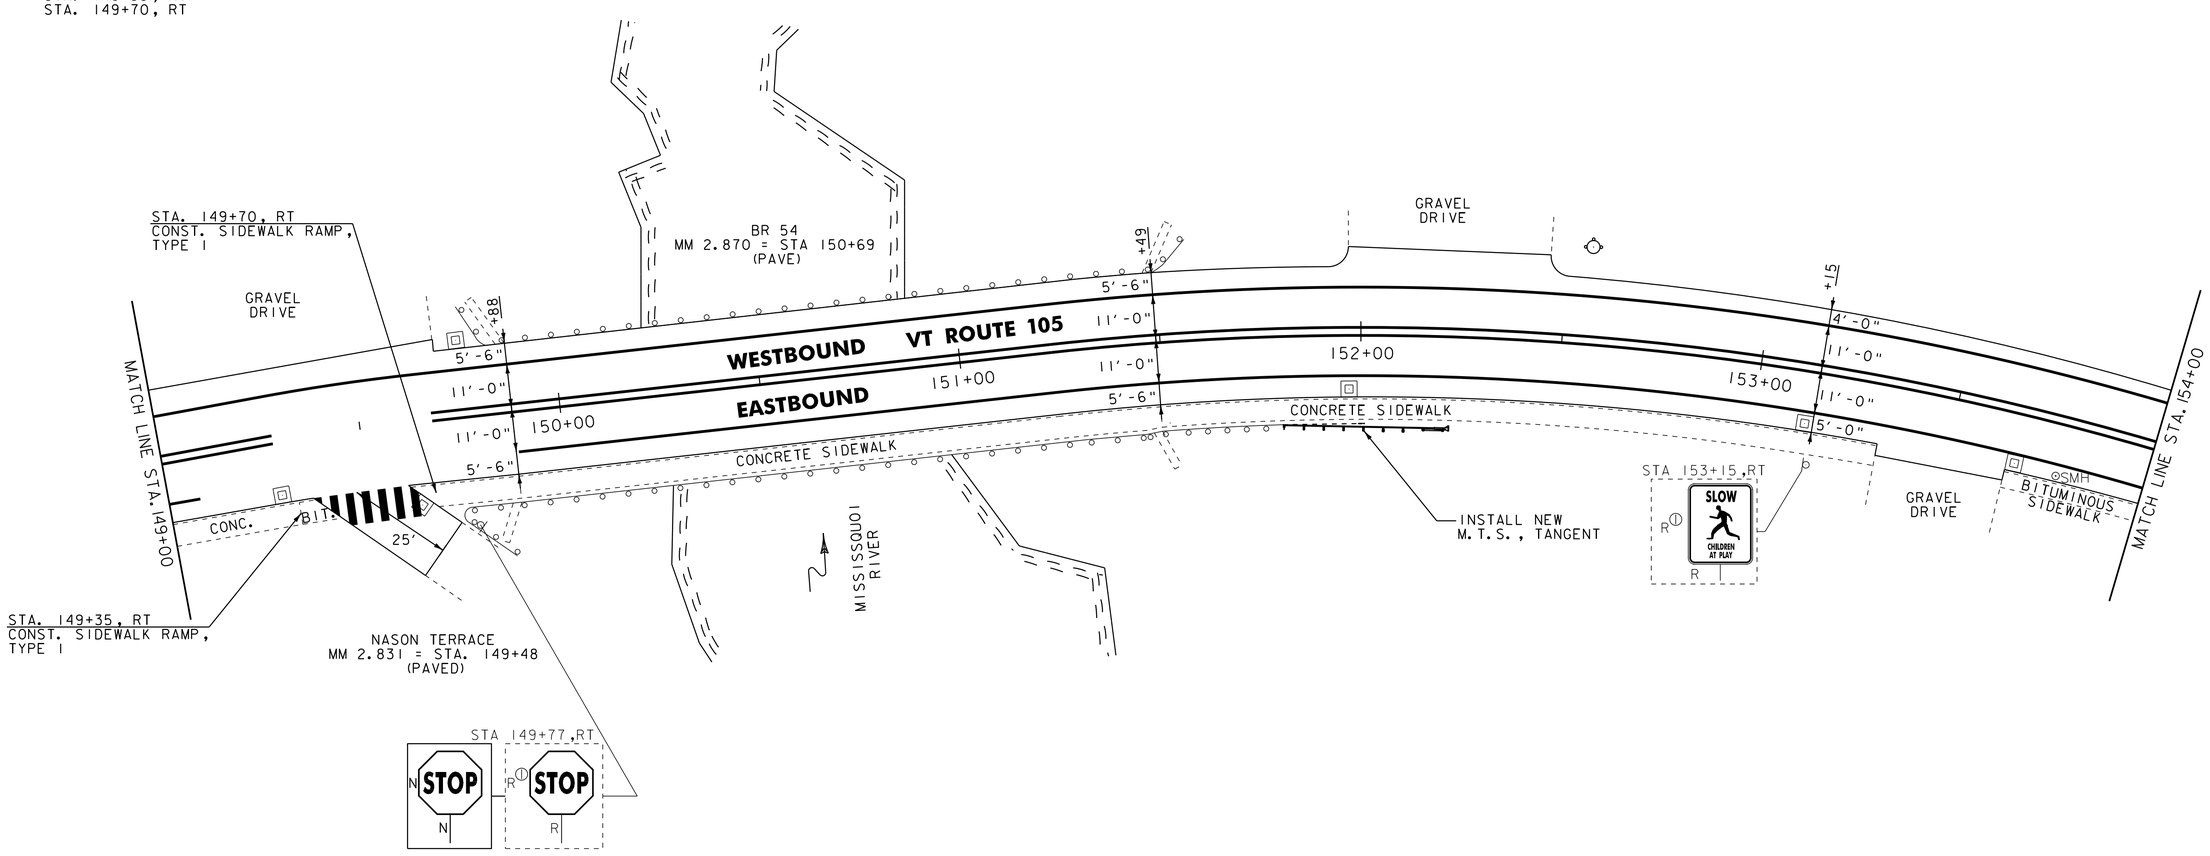

NOTES:
1. ALL EXISTING SIGNS NOT SHOWN SHALL BE RETAINED.
2. FOR LEGENDS, SEE LAYOUT SHEET #1.

NOT TO SCALE

Stantec

PROJECT LAYOUT SHEET #5

PROJECT NAME: NORTH TROY
PROJECT NUMBER: STP 2620(1)

FILE NAME: p06b208.dgn
PROJECT LEADER: JLL
DESIGNED BY: MCF
IPARM FILE: p06b208l05.i

PLOT DATE: 25-OCT-2011 14:03
DRAWN BY: STANTEC
CHECKED BY: JLL
SHEET 89 OF 116