STATE OF VERMONT
AGENCY OF TRANSPORTATION

TRAFFIC SIGN SUMMARY SHEET

MILEMARKER, STATION, OR SIGN NUMBER	SIGN LEGEND	SIGN DIMENSIONS EA	SIGN DIMENSIONS WIDTH (in)	SIGN DIMENSIONS HEIGHT (in)	NEW & SALVAGED SIGNS "A"	NEW & SALVAGED SIGNS "B"	NEW & SALVAGED SIGNS REMOVE ~~SALV~~ SIGN	NEW & SALVAGED SIGNS SALV TIS	EXIST POST RETAIN	EXIST POST SALVAGE	NO. OF POSTS	FLANGED CHANNEL lb/ft 1.12	FLANGED CHANNEL lb/ft 2.0	FLANGED CHANNEL lb/ft 3.0	SQUARE STEEL (in) 1.75, lb/ft 1.88	SQUARE STEEL (in) 2.0, lb/ft 2.42	SQUARE STEEL (in) 2.5, lb/ft 3.35	ANCHOR	SLEEVE	TUBULAR ALUMINUM Ø (in) 3.0, lb/ft 1.3	TUBULAR ALUMINUM Ø (in) 4.0, lb/ft 1.7	TUBULAR ALUMINUM Ø (in) 4.0 MOD, lb/ft 1.7	FOUNDATION	TUBULAR STEEL Ø (in) 3.0, lb/ft 7.6	TUBULAR STEEL Ø (in) 3.5, lb/ft 9.0	TUBULAR STEEL Ø (in) 4.0, lb/ft 10.8	TUBULAR STEEL Ø (in) 5.0, lb/ft 14.6	W-SHAPE STEEL FTG. SIZE 24"	W-SHAPE STEEL FTG. SIZE 30"	W-SHAPE STEEL WEIGHT	W-SHAPE STEEL POST SIZE	SIGN FRAME REQUIRED	REMARKS	SIGN DETAIL: DETAIL ON SHEET NUMBER	SIGN DETAIL: STD. SHEET NUMBER
VT ROUTE 243												OPTION ITEMS																							
6+50, LT	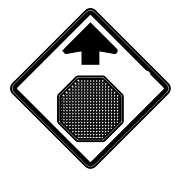	1	36	36	9.0						2					14.0 X 14.7		X															SIGN ID CODE W3-1		E-150
11+39, RT	EAST	1	24	12	2.0		1																										MOUNT NEW SIGN ON EXISTING ASSEMBLY		E-136B
43+65, LT	WEST	1	24	12	2.0		1																										MOUNT NEW SIGN ON EXISTING ASSEMBLY		E-136B
44+56, RT	EAST	1	24	12	2.0		1																										MOUNT NEW SIGN ON EXISTING ASSEMBLY		E-136B
45+49 RT							1																												
												FT	FT	FT	FT	FT ~~30~~	FT		EA	LB	LB	LB		LB	LB	LB	LB								
TOTALS					SF 15.00	SF	EA. 4	SF				FT			28.7 FT ~~30~~					LB			EA.	LB				EA.	EA.	LB					

FINAL POST LENGTHS ARE TO BE DETERMINED IN THE FIELD. POST SIZES ARE COMPUTED BASED ON INFORMATION FURNISHED ON THE STANDARD SHEETS AND THE VAOT "SIGN POST DESIGN GUIDELINE."

Stantec

PROJECT NAME: TROY
PROJECT NUMBER: STP 2621(1)

FILE NAME: p07c200.dgn
PROJECT LEADER: JLL
DESIGNED BY: MCF
IPARM FILE: p06c210tss.i

PLOT DATE: 25-OCT-2011 14:05
DRAWN BY: STANTEC
CHECKED BY: JLL
SHEET 116 OF 116