TEMPORARY 4 INCH WHITE LINE, PAINT
DURABLE 4 INCH WHITE LINE (OPTION BID ITEM)
289+50 TO 295+50 SOLID RT
289+50 TO 290+81 SOLID LT
290+81 TO 291+23 SOLID LT (TH 17)
291+45 TO 291+74 SOLID LT (TH 17)
291+74 TO 295+50 SOLID LT

TEMPORARY 4 INCH YELLOW LINE, PAINT
DURABLE 4 INCH YELLOW LINE (OPTION BID ITEM)
289+50 TO 291+14 SOLID LT & RT
291+34 DOUBLE SOLID LT & RT (TH 17)
291+54 TO 295+50 SOLID LT & RT

TEMPORARY 24 INCH STOP BAR, PAINT
DURABLE 24 INCH STOP BAR (OPTION BID ITEM)
291+05 TO 291+33 LT (TH 17)

TEMPORARY LETTER OR SYMBOL, PAINT
DURABLE LETTER OR SYMBOL (OPTION BID ITEM)
291+26 LT "STOP" (TH 17)

STEEL BEAM GUARDRAIL, GALVANIZED
291+74 TO 293+49 RT
294+49 TO 294+74 RT
294+57 TO 295+50 LT

GUARDRAIL APPROACH SECTION, GALV HD STEEL BEAM
293+49 TO 293+74 RT
293+57 TO 293+82 LT
294+24 TO 294+49 RT
294+32 TO 294+57 LT

ANCHOR FOR STEEL BEAM RAIL
3 (SEE STANDARD G-1d)

REMOVAL AND DISPOSAL OF GUARDRAIL
291+74 TO 293+74 RT
293+57 TO 293+82 LT
294+24 TO 294+74 RT
294+32 TO 295+07 LT

DELINEATOR WITH STEEL POST
291+74 RT
293+57 LT
294+74 RT

REMOVING SIGNS
11 - AS SHOWN

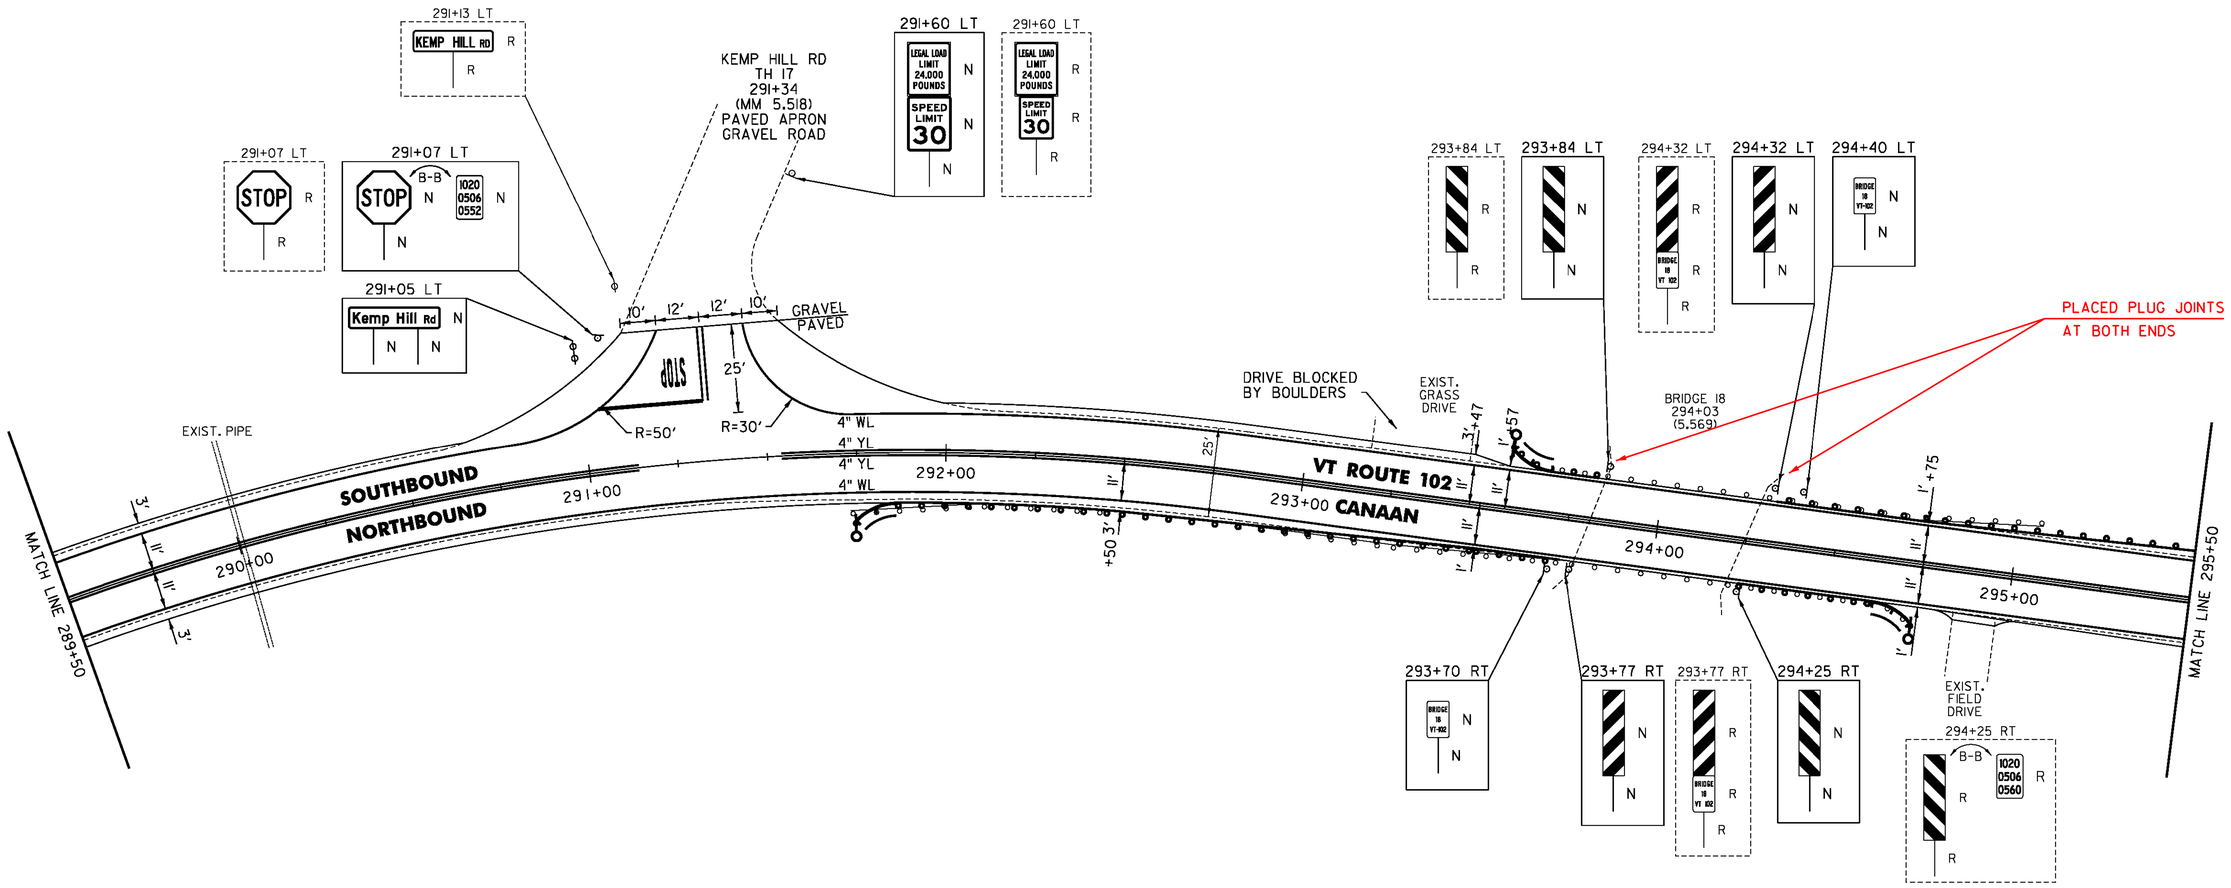

NOT TO SCALE

PROJECT NAME:	LEMINGTON-CANAAN
PROJECT NUMBER:	STP 2723(I)
FILE NAME: z07c214bdr.dgn	PLOT DATE: 2/28/2015
PROJECT LEADER: P. SHEDD	DRAWN BY: W. GORDON
DESIGNED BY: N. LEMAY	CHECKED BY: P. SHEDD
VT 102 PLAN SHEET 82	SHEET 105 OF 162

CLD 14-0197