203.16 SOLID ROCK EXCAVATION
STA. 17+89 - STA. 17+98 RT
STA. 18+14 - STA. 18+40 LT
STA. 18+38 - STA. 18+47 RT
STA. 18+53 - STA. 18+60 RT
STA. 18+77 - STA. 18+91 LT

604.42 CHANGING ELEVATION OF SEWER MANHOLES
STA. 18+47 LT

618.10 PORTLAND CEMENT CONCRETE SIDEWALK, 5 INCH
STA. 17+89 - STA. 17+98 RT
STA. 18+14 - STA. 18+40 LT
STA. 18+38 - STA. 18+47 RT
STA. 18+53 - STA. 18+60 RT
STA. 18+77 - STA. 18+91 LT
STA. 19+20 - STA. 19+25 LT
STA. 19+36 - STA. 19+72 LT

618.30 DETECTABLE WARNING SURFACE
STA. 17+95 RT
STA. 18+22 LT
STA. 18+35 LT
STA. 18+42 RT
STA. 18+57 RT
STA. 18+80 LT
STA. 18+85 LT
STA. 19+23 LT
STA. 19+38 LT

616.28 CAST-IN-PLACE CONCRETE CURB, TYPE B
STA. 18+88 - STA. 19+22 LT
STA. 19+32 - STA. 19+82 LT
STA. 19+32 - STA. 20+08 LT

616.41 REMOVAL OF EXISTING CURB
STA. 18+88 - STA. 19+22 LT
STA. 19+66 - STA. 19+82 LT
STA. 19+66 - STA. 20+08 LT

629.20 ADJUST ELEVATION OF VALVE BOX
STA. 18+07 CL (WSV)
STA. 18+44 RT (WSV)
STA. 18+58 LT (WSV)
STA. 18+62 LT (WSV)
STA. 18+64 RT (WSV)

646.406 DURABLE 4" WHITE LINE, RECESSED POLYUREA
STA. 17+25 - STA. 17+83 (SOLID RT)
STA. 17+25 - STA. 18+17 (SOLID LT)
STA. 19+93 - STA. 22+75 (SOLID LT)

646.602 TEMPORARY 4" WHITE LINE, PAINT
STA. 17+25 - STA. 17+83 (SOLID RT)
STA. 17+25 - STA. 18+17 (SOLID LT)
STA. 19+93 - STA. 22+75 (SOLID LT)

646.416 DURABLE 4" YELLOW LINE, RECESSED POLYUREA
STA. 17+25 - STA. 17+83 (SOLID LT & RT)
STA. 18+14 RT (CENTERLINE HOWARD ST.)
STA. 18+54 LT (CENTERLINE HOWARD ST.)
STA. 19+49 LT (CENTERLINE ST. PAUL ST.)

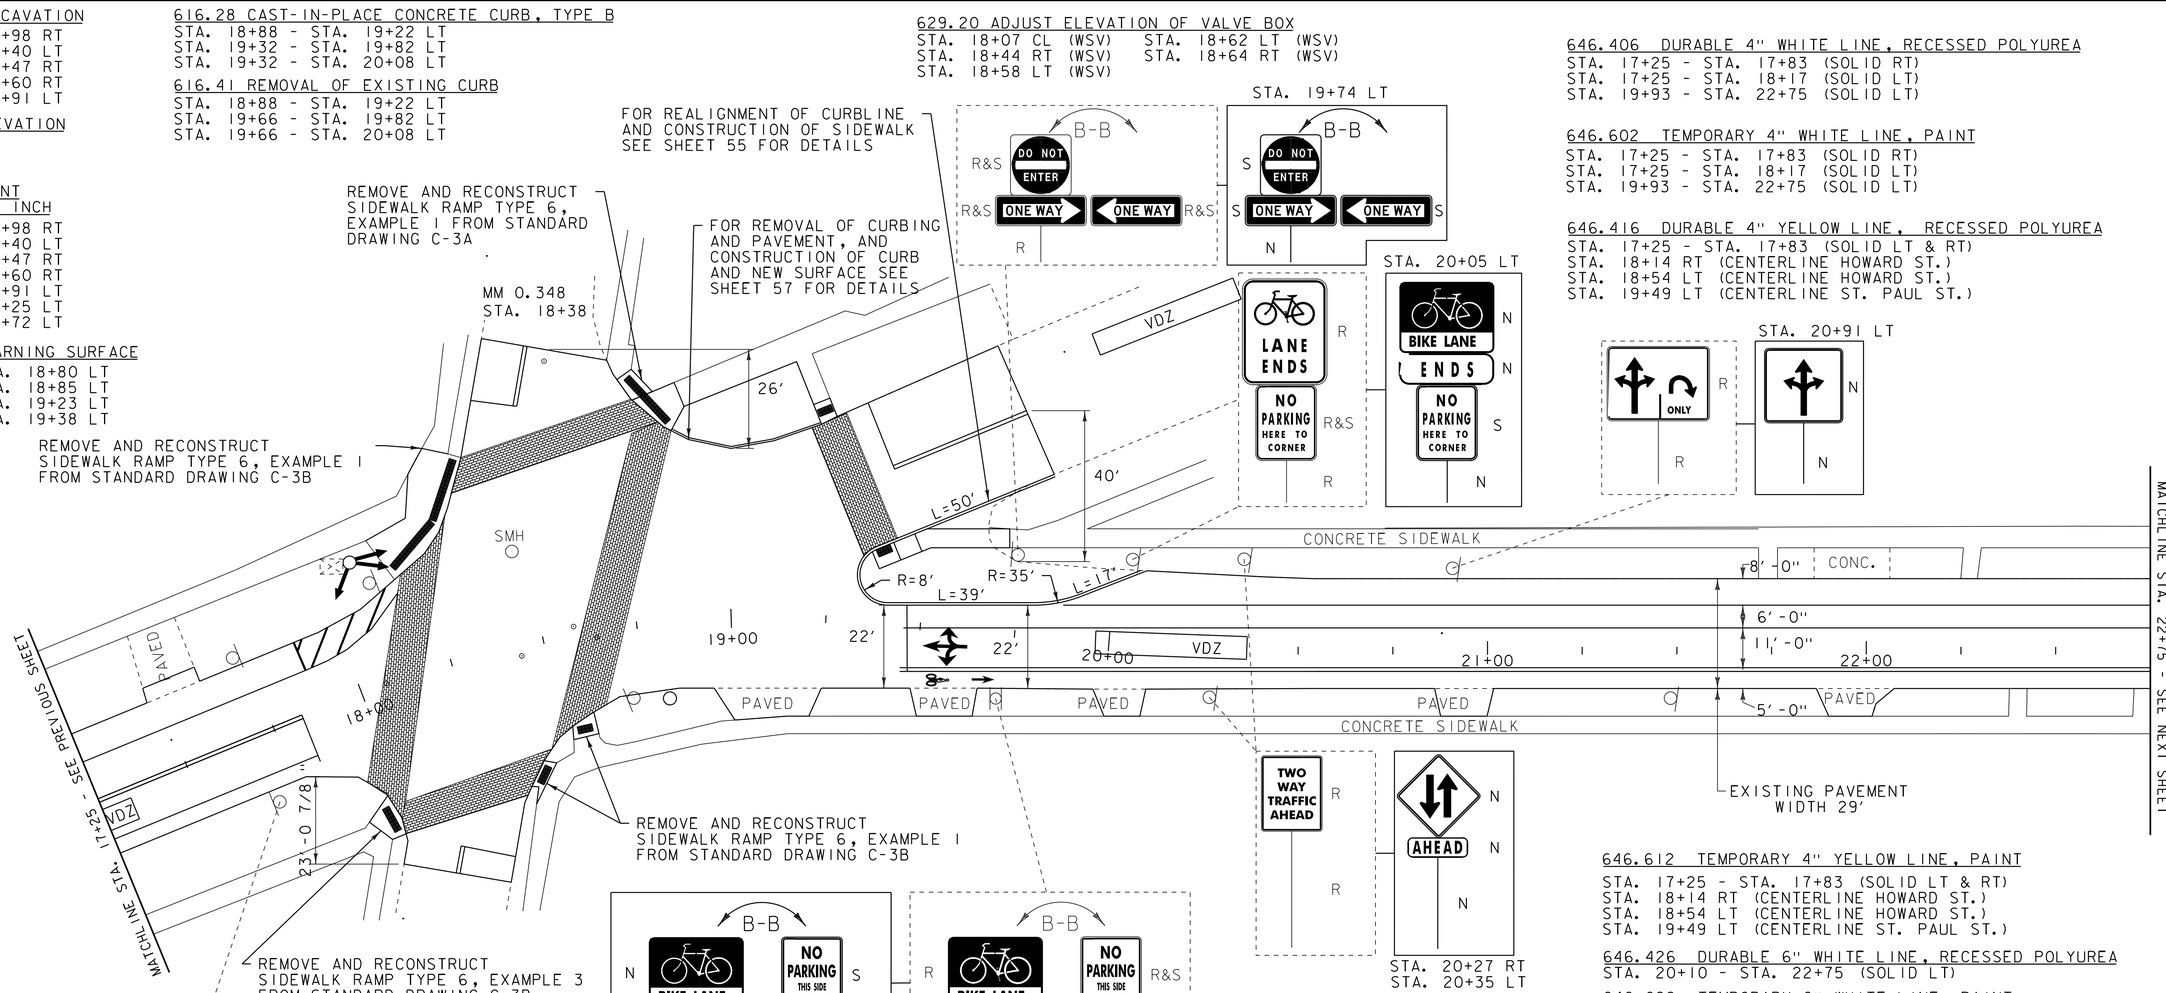

646.612 TEMPORARY 4" YELLOW LINE, PAINT
STA. 17+25 - STA. 17+83 (SOLID LT & RT)
STA. 18+14 RT (CENTERLINE HOWARD ST.)
STA. 18+54 LT (CENTERLINE HOWARD ST.)
STA. 19+49 LT (CENTERLINE ST. PAUL ST.)

646.426 DURABLE 6" WHITE LINE, RECESSED POLYUREA
STA. 20+10 - STA. 22+75 (SOLID LT)

646.622 TEMPORARY 6" WHITE LINE, PAINT
STA. 20+10 - STA. 22+75 (SOLID LT)

646.702 TEMPORARY CROSSWALK MARKING, PAINT
STA. 17+97 - STA. 18+24 RT & LT
STA. 17+98 - STA. 18+40 RT
STA. 18+37 - STA. 18+82 LT
STA. 18+57 - STA. 18+85 RT & LT

900.620 SPECIAL PROVISION (VIDEO VEHICLE DETECTION SYSTEM) (U.S. ALT. ROUTE 7 @ HOWARD & ST. PAUL ST.)
STA. 18+08 LT
STA. 18+08 LT
STA. 18+08 LT

900.640 SPECIAL PROVISION (DURABLE CROSSWALK MARKING, IMPRINTED/COLORIZED)
STA. 17+97 - STA. 18+24 RT & LT
STA. 17+98 - STA. 18+40 RT
STA. 18+37 - STA. 18+82 LT
STA. 18+57 - STA. 18+85 RT & LT

675.50 REMOVING SIGNS
AS SHOWN - 11

675.60 ERECTING SALVAGED SIGNS
AS SHOWN - 5

646.436 DURABLE 6" YELLOW LINE, RECESSED POLYUREA
STA. 19+45 - STA. 22+75 (CENTERLINE RT)

646.446 DURABLE 8" WHITE LINE, RECESSED POLYUREA
STA. 17+89 - STA. 18+16 (HATCHED LT)

646.486 DURABLE 24" STOP BAR, RECESSED POLYUREA
STA. 17+82 RT
STA. 18+13 - STA. 18+28 RT
STA. 18+44 - STA. 18+54 LT
STA. 19+40 - STA. 19+50 LT
STA. 19+45 RT - STA. 19+67 LT

646.491 DURABLE LETTER OR SYMBOL, TYPE I TAPE
STA. 19+57 RT ARROW
STA. 19+57 RT ARROW
STA. 19+57 RT ARROW
STA. 19+57 RT BIKE
STA. 19+63 RT ARROW

646.692 TEMPORARY LETTER OR SYMBOL, PAINT
STA. 19+57 RT ARROW
STA. 19+57 RT ARROW
STA. 19+57 RT ARROW
STA. 19+57 RT BIKE
STA. 19+63 RT ARROW

646.632 TEMPORARY 6" YELLOW LINE, PAINT
STA. 19+45 - STA. 22+75 (CENTERLINE RT)

646.642 TEMPORARY 8" WHITE LINE, PAINT
STA. 17+89 - STA. 18+16 (HATCHED LT)

646.682 TEMPORARY 24" STOP BAR, PAINT
STA. 17+82 RT
STA. 18+13 - STA. 18+28 RT
STA. 18+44 - STA. 18+54 LT
STA. 19+40 - STA. 19+50 LT
STA. 19+45 RT - STA. 19+67 LT

LEGEND
HYDRANT
MANHOLE
VALVE
GAS PIPELINE MARKER
CATCH BASIN / DROP INLET
CURB INLET
TRAFFIC CONTROL BOX
PARKING METER
VDZ VIDEO DETECTION ZONE
VIDEO CAMERA

SIGN LEGEND
R = REMOVE
R&S = REMOVE AND SALVAGE
RET = RETAIN
S = SALVAGE
N = NEW
B-B = BACK TO BACK

NOT TO SCALE

PROJECT LAYOUT SHEET 4

PROJECT NAME: BURLINGTON (CLASS I)
PROJECT NUMBER: STP 2722 (I)

FILE NAME: 07d028.dgn
PROJECT LEADER: EPD
DESIGNED BY: CDL
PLOT FILE: 07d028_18.i
PLOT DATE: 05-JUN-2014 11:20
DRAWN BY: SJL
CHECKED BY: EPD
SHEET 18 OF 61