203.16 SOLID ROCK EXCAVATION
STA. 66+37 - STA. 66+53 LT
STA. 66+40 - STA. 66+54 RT
STA. 66+94 - STA. 67+08 RT
STA. 66+99 - STA. 67+12 LT

604.412, 604.415, 604.418 REHAB, DROP INLETS, CATCH BASINS, OR MANHOLES, CLASS I, CLASS II OR CLASS III
STA. 66+94 RT "TYPE D GRATE"

604.40 CHANGING ELEVATION OF DROP INLETS, CATCH BASINS, OR MANHOLES
STA. 65+80 LT (EMH) STA. 67+06 LT (EMH)
STA. 67+00 RT (TEL.)

604.42 CHANGING ELEVATION OF SEWER MANHOLES
STA. 66+73 RT

616.28 CAST-IN-PLACE CONCRETE CURB, TYPE B
STA. 66+38 - STA. 66+53 LT
STA. 66+40 - STA. 66+54 RT
STA. 66+94 - STA. 67+08 RT

616.41 REMOVAL OF EXISTING CURB
STA. 66+38 - STA. 66+53 LT
STA. 66+40 - STA. 66+54 RT
STA. 66+94 - STA. 67+08 RT

618.10 PORTLAND CEMENT CONCRETE SIDEWALK, 5 INCH
STA. 66+37 - STA. 66+53 LT
STA. 66+40 - STA. 66+54 RT
STA. 66+94 - STA. 67+08 RT
STA. 66+99 - STA. 67+12 LT

618.30 DETECTABLE WARNING SURFACE
STA. 66+44 RT STA. 66+98 RT
STA. 66+45 LT STA. 67+02 LT
STA. 66+50 LT STA. 67+04 RT
STA. 66+51 RT STA. 67+08 LT

629.20 ADJUST ELEVATION OF VALVE BOX
STA. 66+29 LT (WSV) STA. 66+82 RT (GSV)
STA. 66+32 LT (WSV) STA. 66+82 RT (GSV)
STA. 66+54 LT (GSV) STA. 66+90 LT (WSV)
STA. 66+60 RT (GSV) STA. 67+09 LT (WSV)
STA. 66+80 RT (GSV) STA. 67+16 RT (GSV)

646.406 DURABLE 4" WHITE LINE, RECESSED POLYUREA
STA. 65+25 - STA. 66+40 (DASHED LT)
STA. 65+25 - STA. 66+35 (SOLID RT)
STA. 66+65 LT
STA. 66+82 RT
STA. 67+15 - STA. 67+90 (SOLID LT)
STA. 67+15 - STA. 67+90 (SOLID RT)
STA. 67+90 - STA. 68+50 (DOTTED LT)
STA. 67+90 - STA. 68+50 (DOTTED RT)
STA. 68+40 - STA. 71+25 LT (PARKING STALLS)
STA. 68+48 - STA. 71+25 RT (PARKING STALLS)

646.486 DURABLE 24" STOP BAR, RECESSED POLYUREA
STA. 66+35 RT
STA. 66+53 - STA. 66+76 LT
STA. 66+83 - STA. 66+94 RT
STA. 67+15 LT & RT

646.682 TEMPORARY 24" STOP BAR, PAINT
STA. 66+35 RT
STA. 66+53 - STA. 66+76 LT
STA. 66+83 - STA. 66+94 RT
STA. 67+15 LT & RT

646.602 TEMPORARY 4" WHITE LINE, PAINT
STA. 65+25 - STA. 66+40 (DASHED LT)
STA. 65+25 - STA. 66+35 (SOLID RT)
STA. 66+65 LT
STA. 66+82 RT
STA. 67+15 - STA. 67+90 (SOLID LT)
STA. 67+15 - STA. 67+90 (SOLID RT)
STA. 67+90 - STA. 68+50 (DOTTED LT)
STA. 67+90 - STA. 68+50 (DOTTED RT)
STA. 68+40 - STA. 71+25 LT (PARKING STALLS)
STA. 68+48 - STA. 71+25 RT (PARKING STALLS)

646.416 DURABLE 4" YELLOW LINE, RECESSED POLYUREA
STA. 65+25 - STA. 66+36 SOLID LT & RT
STA. 66+76 LT (CENTERLINE PEARL ST.)
STA. 66+70 RT (CENTERLINE PEARL ST.)

646.612 TEMPORARY 4" YELLOW LINE, PAINT
STA. 65+25 - STA. 66+36 SOLID LT & RT
STA. 66+76 LT (CENTERLINE PEARL ST.)
STA. 66+70 RT (CENTERLINE PEARL ST.)

646.691 TEMPORARY LETTER OR SYMBOL, TYPE I TAPE

STA. 65+28 RT ARROW	STA. 67+27 RT ARROW
STA. 65+28 RT ARROW	STA. 67+27 RT ARROW
STA. 65+77 RT "ONLY"	STA. 67+27 LT ARROW
STA. 65+77 RT "ONLY"	STA. 67+27 LT ARROW
STA. 66+25 RT ARROW	STA. 67+76 RT "ONLY"
STA. 66+25 RT ARROW	STA. 68+27 RT ARROW
STA. 66+78 RT ARROW	STA. 68+27 RT ARROW
STA. 66+78 RT ARROW	STA. 68+27 LT ARROW
STA. 66+78 RT "ONLY"	STA. 68+27 LT ARROW

646.492 DURABLE LETTER OR SYMBOL, THERMOPLASTIC

STA. 65+28 RT ARROW	STA. 67+27 RT ARROW
STA. 65+28 RT ARROW	STA. 67+27 RT ARROW
STA. 65+77 RT "ONLY"	STA. 67+27 LT ARROW
STA. 65+77 RT "ONLY"	STA. 67+27 LT ARROW
STA. 66+25 RT ARROW	STA. 67+76 RT "ONLY"
STA. 66+25 RT ARROW	STA. 68+27 RT ARROW
STA. 66+78 RT ARROW	STA. 68+27 RT ARROW
STA. 66+78 RT ARROW	STA. 68+27 LT ARROW
STA. 66+78 RT "ONLY"	STA. 68+27 LT ARROW

646.426 DURABLE 6" WHITE LINE, RECESSED POLYUREA
STA. 68+50 - STA. 71+25 (SOLID LT)

646.622 TEMPORARY 6" WHITE LINE, PAINT
STA. 68+50 - STA. 71+25 (SOLID LT)

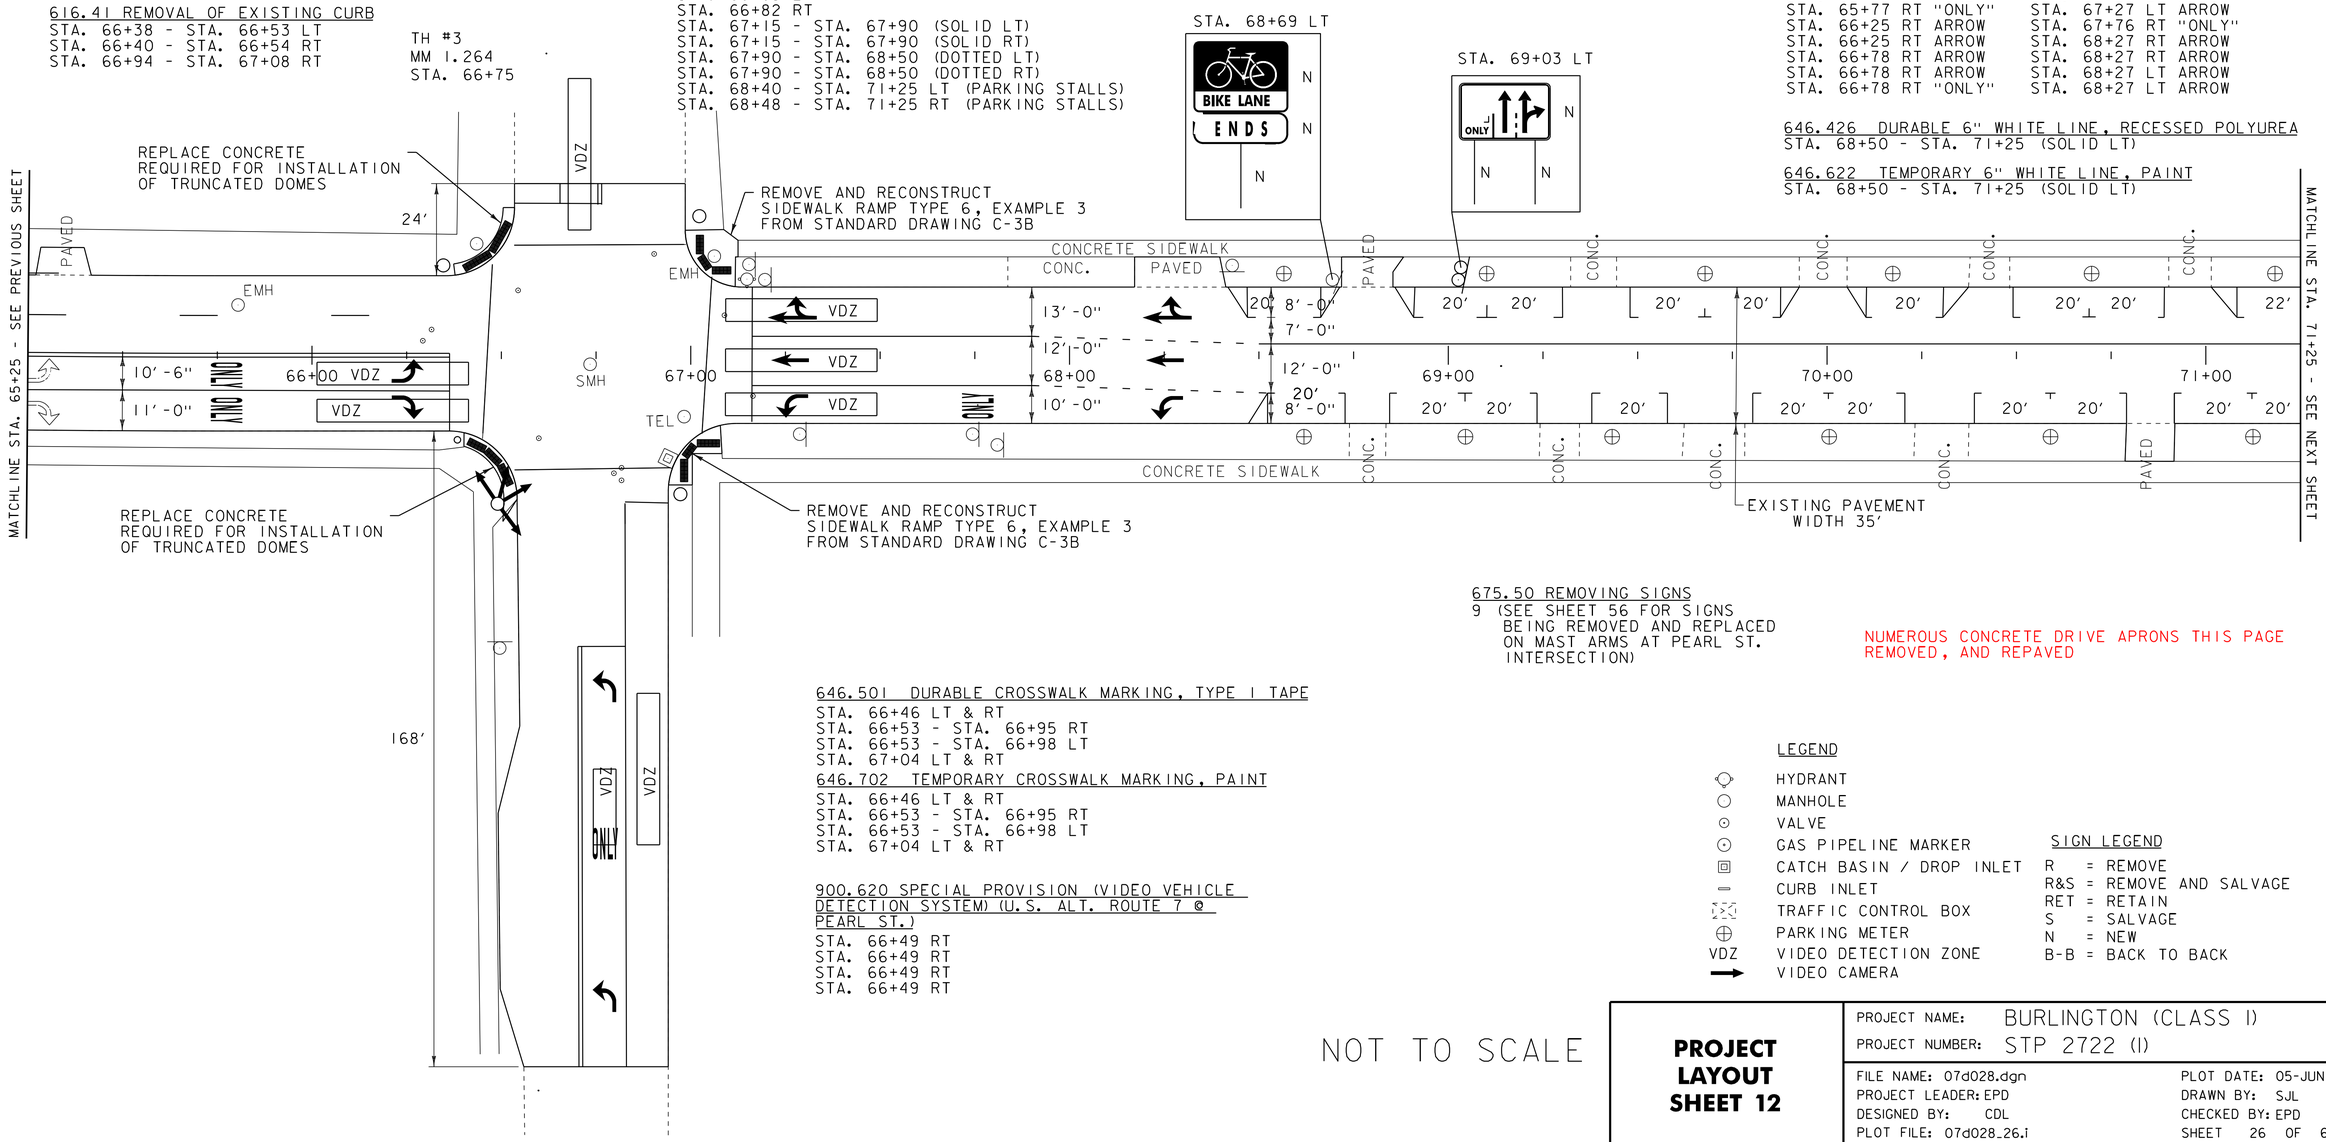

675.50 REMOVING SIGNS
9 (SEE SHEET 56 FOR SIGNS BEING REMOVED AND REPLACED ON MAST ARMS AT PEARL ST. INTERSECTION)

NUMEROUS CONCRETE DRIVE APRONS THIS PAGE REMOVED, AND REPAVED

646.501 DURABLE CROSSWALK MARKING, TYPE I TAPE
STA. 66+46 LT & RT
STA. 66+53 - STA. 66+95 RT
STA. 66+53 - STA. 66+98 LT
STA. 67+04 LT & RT

646.702 TEMPORARY CROSSWALK MARKING, PAINT
STA. 66+46 LT & RT
STA. 66+53 - STA. 66+95 RT
STA. 66+53 - STA. 66+98 LT
STA. 67+04 LT & RT

900.620 SPECIAL PROVISION (VIDEO VEHICLE DETECTION SYSTEM) (U.S. ALT. ROUTE 7 @ PEARL ST.)
STA. 66+49 RT
STA. 66+49 RT
STA. 66+49 RT
STA. 66+49 RT

LEGEND
- HYDRANT
- MANHOLE
- VALVE
- GAS PIPELINE MARKER
- CATCH BASIN / DROP INLET
- CURB INLET
- TRAFFIC CONTROL BOX
- PARKING METER
- VDZ VIDEO DETECTION ZONE
- VIDEO CAMERA

SIGN LEGEND
R = REMOVE
R&S = REMOVE AND SALVAGE
RET = RETAIN
S = SALVAGE
N = NEW
B-B = BACK TO BACK

NOT TO SCALE

PROJECT LAYOUT SHEET 12

PROJECT NAME: BURLINGTON (CLASS I)
PROJECT NUMBER: STP 2722 (I)

FILE NAME: 07d028.dgn
PROJECT LEADER: EPD
DESIGNED BY: CDL
PLOT FILE: 07d028_26.i
PLOT DATE: 05-JUN-2014 11:20
DRAWN BY: SJL
CHECKED BY: EPD
SHEET 26 OF 61