STATE OF VERMONT
AGENCY OF TRANSPORTATION

TRAFFIC SIGN SUMMARY SHEET 03

MILEMARKER, STATION, OR SIGN NUMBER	SIGN LEGEND	SIGN DIMENSIONS EA	WIDTH (in)	HEIGHT (in)	NEW & SALVAGED SIGNS "A"	"B"	SALV SIGN	SALV TIS	EXIST POST RETAIN	EXIST POST SALVAGE	NEW SIGN POSTS NO. OF POSTS	FLANGED CHANNEL lb/ft 1.12	2.0	3.0	SQUARE STEEL (in) 1.75 lb/ft 1.88	2.0 lb/ft 2.42	2.5 lb/ft 3.35	ANCHOR	SLEEVE	TUBULAR ALUMINUM Ø (in) 3.0 lb/ft 1.3	4.0 lb/ft 1.7	4.0 MOD lb/ft 1.7	FOUND-ATION	TUBULAR STEEL Ø (in) 3.0 lb/ft 7.6	3.5 lb/ft 9.0	4.0 lb/ft 10.8	5.0 lb/ft 14.6	W-SHAPE STEEL FTG. SIZE 24"	30"	WEIGHT	POST SIZE	SIGN FRAMED REQUIRED	REMARKS	SIGN DETAIL DETAIL ON SHEET NUMBER	STD. SHEET NUMBER
U.S. ROUTE 5 (CONTINUED)											OPTION ITEMS																									
309+50, LT	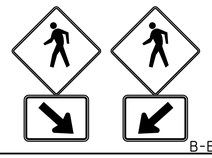 B-B	2	30	30	12.50						1					X			X																MOUNT SIGNS BACK TO BACK SIGN ID CODE W11-2 (FLUORESCENT YELLOW-GREEN)		SEE FHWA SHS
		2	24	12	4.00																														SIGN ID CODE W16-7P (FLUORESCENT YELLOW-GREEN)		SEE FHWA SHS
ALT. U.S. ROUTE 5 ~~0+95, LT~~ ELIMINATED BY VILLAGE OF DERBY LINE	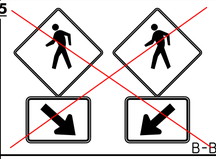 B-B	2	30	30	~~12.50~~						1					X			X																MOUNT SIGNS BACK TO BACK SIGN ID CODE W11-2 (FLUORESCENT YELLOW-GREEN)		SEE FHWA SHS
		2	24	12	~~4.00~~																														SIGN ID CODE W16-7P (FLUORESCENT YELLOW-GREEN)		SEE FHWA SHS
0+98, LT	STOP	1	30	30	6.25						1					X			X																SIGN ID CODE R1-1		SEE FHWA SHS
		1	30	30	6.25																														SIGN ID CODE R3-2		SEE FHWA SHS
	END NO PARKING						1																													-	-
1+95, LT	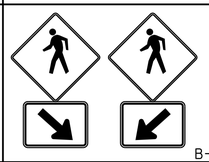 B-B	2	30	30	12.50						1					X			X																MOUNT SIGNS BACK TO BACK SIGN ID CODE W11-2 (FLUORESCENT YELLOW-GREEN)		SEE FHWA SHS
		2	24	12	4.00																														SIGN ID CODE W16-7P (FLUORESCENT YELLOW-GREEN)		SEE FHWA SHS
5+00, LT	STOP	1	30	30	6.25						1					X			X																SIGN ID CODE R1-1		SEE FHWA SHS
FINAL POST LENGTHS ARE TO BE DETERMINED IN THE FIELD. POST SIZES ARE COMPUTED BASED ON INFORMATION FURNISHED ON THE STANDARD SHEETS AND THE VTRANS "SIGN POST DESIGN GUIDELINE."												FT	FT	FT	FT	FT 75	FT		EA	LB	LB	LB		LB	LB	LB	LB								
TOTALS		SF 68.25	SF	EA. 1	SF							FT			FT 75					LB			EA.	LB				EA.	EA.	LB					

PROJECT NAME: DERBY
PROJECT NUMBER: STP 2703(1)

FILE NAME: 07D202.dgn
PROJECT LEADER: JLL
DESIGNED BY: STANTEC
IPARM FILE: 07C194_50.i

PLOT DATE: 29-JAN-2013 09:
DRAWN BY: STANTEC
CHECKED BY: JLL
SHEET 50 OF 62