STATE OF VERMONT
AGENCY OF TRANSPORTATION

TRAFFIC SIGN SUMMARY SHEET 1

MILEMARKER, STATION, OR SIGN NUMBER	SIGN LEGEND	SIGN DIMENSIONS EA	SIGN DIMENSIONS WIDTH (in)	SIGN DIMENSIONS HEIGHT (in)	NEW & SALVAGED SIGNS "A"	NEW & SALVAGED SIGNS "B"	NEW & SALVAGED SIGNS SALV SIGN	NEW & SALVAGED SIGNS SALV TIS	EXIST POST RETAIN	EXIST POST SALVAGE	NEW SIGN POSTS NO. OF POSTS	FLANGED CHANNEL lb/ft 1.12	FLANGED CHANNEL lb/ft 2.0	FLANGED CHANNEL lb/ft 3.0	SQUARE STEEL (in) lb/ft 1.75 1.88	SQUARE STEEL (in) lb/ft 2.0 2.42	SQUARE STEEL (in) lb/ft 2.5 3.35	ANCHOR	SLEEVE	TUBULAR ALUMINUM Ø (in) lb/ft 3.0 1.3	TUBULAR ALUMINUM Ø (in) lb/ft 4.0 1.7	TUBULAR ALUMINUM Ø (in) lb/ft 4.0 MOD 1.7	TUBULAR STEEL Ø (in) lb/ft FOUNDATION SIGN REMOVAL	TUBULAR STEEL Ø (in) lb/ft 3.0 7.6	TUBULAR STEEL Ø (in) lb/ft 3.5 9.0	TUBULAR STEEL Ø (in) lb/ft 4.0 10.8	TUBULAR STEEL Ø (in) lb/ft 5.0 14.6	W-SHAPE STEEL FTG. SIZE 24"	W-SHAPE STEEL FTG. SIZE 30"	W-SHAPE STEEL WEIGHT	W-SHAPE STEEL POST SIZE	SIGN FRAME REQUIRED	REMARKS	SIGN DETAIL DETAIL ON SHEET NUMBER	SIGN DETAIL STD. SHEET NUMBER
												OPTION ITEMS																							
STA. 12+25 LT	S	1 1	30 30	24 12	5.00 2.50		1				2					X		X					3										R3-17 R3-17A		E-143B E-143B
STA. 12+44 RT	NOT INSTALLED 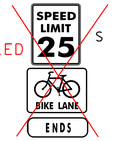 S	1 1	30 30	24 12	5.00 2.50		1				1					X		X															R3-17 R3-17B		E-143B E-143B
STA. 13+85 RT							1				1					~~X~~		X					1												
STA. 13+92 RT		1 1	24 24	36 12	6.00 2.00						1					X		X					2										R3-9B M4-11		E-140 E-140
STA. 13+95 LT		1 1	24 24	36 12	6.00 2.00						1					X		X					2										R3-9B M4-6		E-140 E-140
STA. 14+02 LT							1				1					X		X					1												
STA. 14+70 RT		1	24	24	4.00						1					X		X					1										W10-1		E-153B
STA. 15+11 LT		1	24	36	6.00		1				1					X		X					2										R3-9B		E-140
STA. 16+88 RT	→ MISSING	1 1	24 24	36 12	6.00 2.00		1				1					X		X															R3-9B M4-6		E-140 E-140
STA. 17+27 LT		1 1	24 24	36 12	6.00 2.00		1				1					X		X					3										R3-9B M4-11		E-140 E-140
STA. 18+34 RT		1	36	36	9.00						2					X		X															W10-12		
												FT	FT	FT	FT	FT 195	FT		EA	LB	LB	LB		LB	LB	LB	LB								
					SF 66.00	SF	EA. 7	SF				FT			FT 195					LB			EA.	LB				EA.	EA.	LB					

FINAL POST LENGTHS ARE TO BE DETERMINED IN THE FIELD. POST SIZES ARE COMPUTED BASED ON INFORMATION FURNISHED ON THE VTRANS STANDARD SHEETS AND "SIGN POST DESIGN GUIDELINE".

TRAFFIC SIGN SUMMARY SHEET 1

PROJECT NAME: WINOOSKI
PROJECT NUMBER: STP 2617(1)S

FILE NAME: 06d064.dgn
PROJECT LEADER: CDL
DESIGNED BY: SJL
PLOT FILE: 06D064_82.dgn

PLOT DATE: 31-OCT-2011 16:47
DRAWN BY: SJL
CHECKED BY: EPD
SHEET 82 OF 88