I–91 RUTFILL LOCATIONS

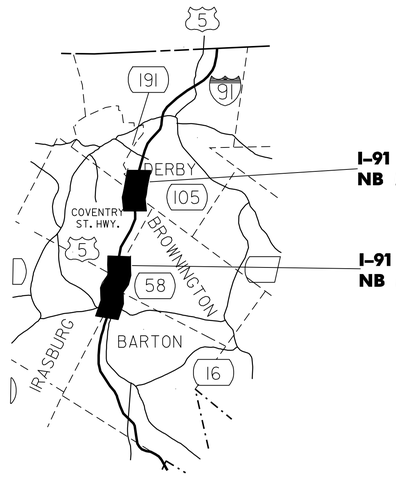

I–91 COVENTRY–DERBY
NB MM ~~167.20~~ 168.90
167.208

I–91 BARTON–COVENTRY
NB MM ~~161.00~~ ~~165.20~~
161.018-165.202

ROUTE	TOWN BEGINNING	MM BEGINNING	TOWN END	MM ENDING	LENGTH (MILES)	LENGTH (FT)	REMARKS
		161.018		~~165.202~~	~~4.184~~	~~22 092~~	
I-91 NB	BARTON	~~161.00~~	COVENTRY	~~165.20~~	~~4.20~~	~~22 176~~	MILL 1.25 in, PAVE
	COVENTRY	~~167.20~~ 167.208	DERBY	168.90	~~1.70~~ 1.692	~~8 976~~ 8 933	MILL 1.25 in, PAVE
				TOTAL	~~5.90~~ 5.876	~~31 152~~ 31 025	

PROJECT LOCATION SHEET

PROJECT NAME: STATEWIDE
PROJECT NUMBER: IM RUTF(1)

FILE NAME: /pave/07k008/pk008.dgn
PROJECT LEADER: WOOLAVER
DESIGNED BY: JLR
pk008dt01.i

PLOT DATE: 15-MAY-2008 08:
DRAWN BY: JLR
CHECKED BY: JLR
SHEET 4 OF 7