INDEX OF SHEETS

SEE SHEET 2

STATE OF VERMONT
AGENCY OF TRANSPORTATION

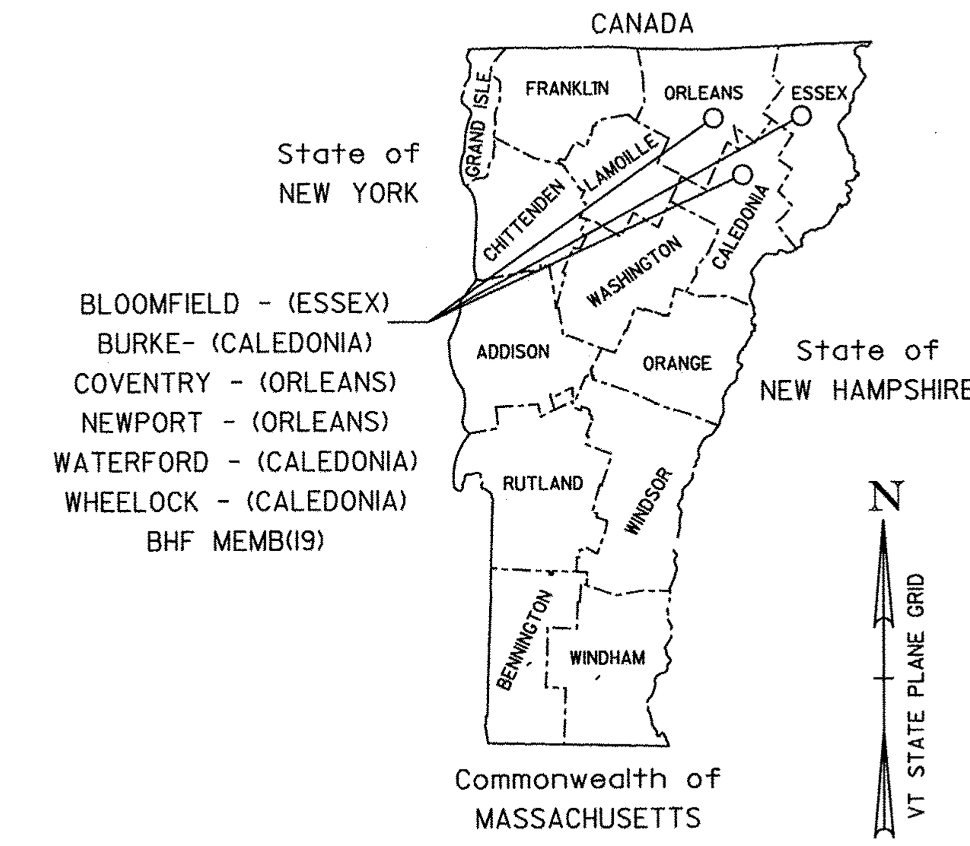

PROPOSED IMPROVEMENT
BRIDGE PROJECT

TOWNS OF BLOOMFIELD, BURKE, NEWPORT, COVENTRY, WATERFORD, AND WHEELOCK
COUNTIES OF ORLEANS, ESSEX, AND CALEDONIA
BRIDGE NO. 96 & 97 ON VT 105 (BLOOMFIELD), NO. 1 ON VT 5A (BURKE), NO. 174 ON U.S. 5 & NO. D08N & D08S ON TH3 (COVENTRY), NO. 57, NO. 58 & NO. 59 ON VT 105 (NEWPORT), NO. 9 ON VT 18 (WATERFORD), & NO. 12 ON VT 122 (WHEELOCK)

PROJECT LOCATIONS:

BR 96 IS LOCATED ON VT 105 (MM 0.75) OVER NULHEGAN RIVER IN THE TOWN OF BLOOMFIELD
BR 97 IS LOCATED ON VT 105 (MM1.75) OVER EAST BR. NULHEGAN RIVER IN THE TOWN OF BLOOMFIELD
BR 1 IS LOCATED ON VT 5A (MM 0.04) OVER SUTTON RIVER IN THE TOWN OF BURKE
BR 174 IS LOCATED ON US 5 (MM 1.11) OVER BLACK RIVER IN THE TOWN OF COVENTRY
BR D08N (I-91 BR108N) IS LOCATED ON TH3 (MM 1.81) OVER I-91 (MM 165.795) IN THE TOWN OF COVENTRY
BR D08S (I-91 BR108S) IS LOCATED ON TH3 (MM 1.77) OVER I-91 (MM 165.795) IN THE TOWN OF COVENTRY
BR 57 IS LOCATED ON VT 105 (MM 0.17) OVER MUD CREEK IN THE TOWN OF NEWPORT
BR 58 IS LOCATED ON VT 105 (MM 1.02) OVER MUD CREEK IN THE TOWN OF NEWPORT
BR 59 IS LOCATED ON VT 105 (MM 1.22) OVER MUD CREEK IN THE TOWN OF NEWPORT
BR 9 IS LOCATED ON VT 18 (MM 7.38) OVER I-93 IN THE TOWN OF WATERFORD
BR 12 IS LOCATED ON VT 122 (MM 0.96) OVER MILLERS RUN IN THE TOWN OF WHEELOCK

PROJECT DESCRIPTION: THIS PROJECT INVOLVES REMOVING AND REPLACING THE SHEET MEMBRANE WATERPROOFING AND BITUMINOUS CONCRETE PAVEMENT ON THE BRIDGES AND THE APPROACHES ALONG WITH MINOR WORK.

LENGTH OF STRUCTURES:

BR 96	73.72'
BR 97	84.04'
BR 1	59.00'
BR 174	141.74'
BR D08N	122.68'
BR D08S	123.76'
BR 57	54.00'
BR 58	99.00'
BR 59	33.00'
BR 9	213.67'
BR 12	92.01'

TOTAL LENGTH OF BRIDGES: 1096.62 FEET

CONVENTIONAL SYMBOLS

COUNTY LINE (COUNTY LINE)
TOWN LINE (TOWN LINE)
LIMITS OF ACCESS
POINT OF ACCESS (X)
FENCE LINE
STONE WALL
TRAVELED WAY
GUARD RAIL
RAILROAD
SURVEY LINE
CULVERT
POWER POLE
TELEPHONE POLE
TREES
CONTROL OF ACCESS
PROPERTY LINE
R.O.W. TAKING LINE
SLOPE RIGHTS (SR)
TOP OF CUT
TOE OF SLOPE

RECORD PLANS

CONTRACTOR: PIKE INDUSTRIES, INC. - BERLIN, VT
RESIDENT ENGINEER: SHANE MORIN
CONSTRUCTION BEGAN: APRIL 19, 2010
CONSTRUCTION COMPLETE: JULY 8, 2011
RECORD PLANS BY: SHANE MORIN & AMOS KEMPTON

I HEREBY CERTIFY THAT ALL THE CONSTUCTION REQUIRED BY THIS SET OF DRAWINGS HAS BEEN ACCOMPLISHED AS INDICATED HEREIN.

BY Shane Morin RESIDENT ENGINEER

DATE 10/19/2011

NOTE: Any further information concerning final quantities, amounts or other details relative to this project may be found at Central Files in the electronic archives.

STATE OF VERMONT RICHARD M. ... No. 7719 Structural 1 LICENSED PROFESSIONAL ENGINEER

T·Y·LIN INTERNATIONAL
12 Northbrook Road Falmouth, Maine 04105

THESE PLANS ARE SUBJECT TO SUCH ENGINEERING CHANGES AS MAY BE REQUIRED BY THE FEDERAL HIGHWAY ADMINISTRATION OR THE DIRECTOR OF PROGRAM DEVELOPMENT.

CONSTRUCTION IS TO BE CARRIED ON IN ACCORDANCE WITH THESE PLANS AND THE STANDARD SPECIFICATIONS FOR CONSTRUCTION DATED 2006, AS APPROVED BY THE FEDERAL HIGHWAY ADMINISTRATION ON JUNE 15, 2006 FOR USE ON THIS PROJECT, INCLUDING ALL SUBSEQUENT REVISIONS AND SUCH REVISED SPECIFICATIONS AND SPECIAL PROVISIONS AS ARE INCORPORATED IN THESE PLANS.

DIRECTOR OF PROGRAM DEVELOPMENT
APPROVED [signature] DATE 8/20/09
PROJECT MANAGER : SHERWARD FARNSWORTH
PROJECT NAME : **STATEWIDE - NORTHEAST REGION**
PROJECT NUMBER : BHF MEMB(19)
SHEET 1 OF 80 SHEETS