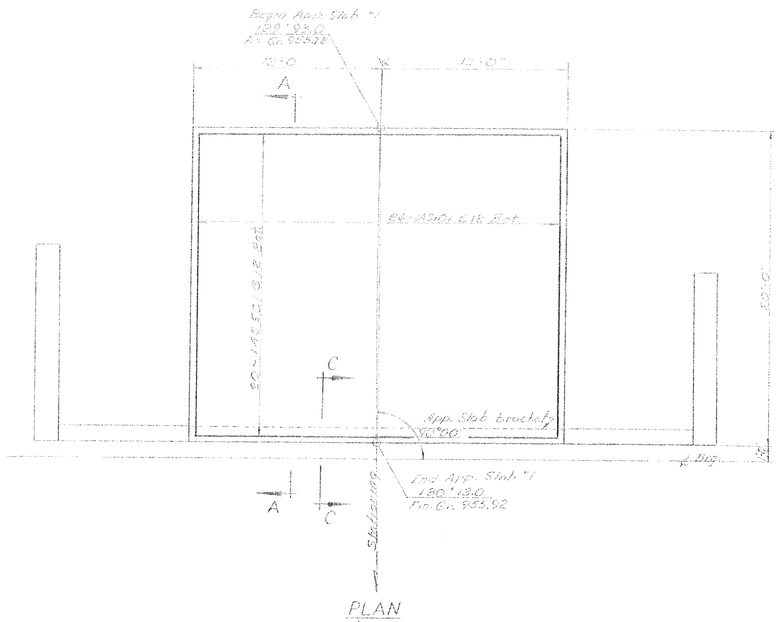

PLAN
1/8"=1'-0"

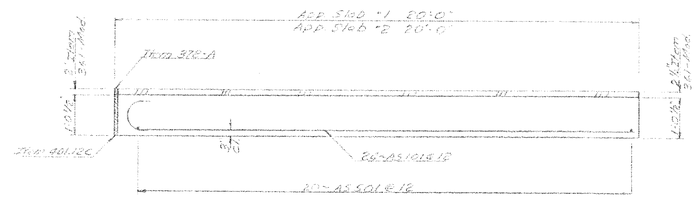

SECTION A-A
N.T.S.

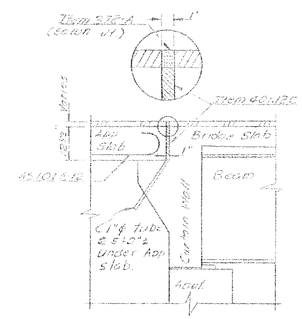

SECTION C-C
N.T.S.

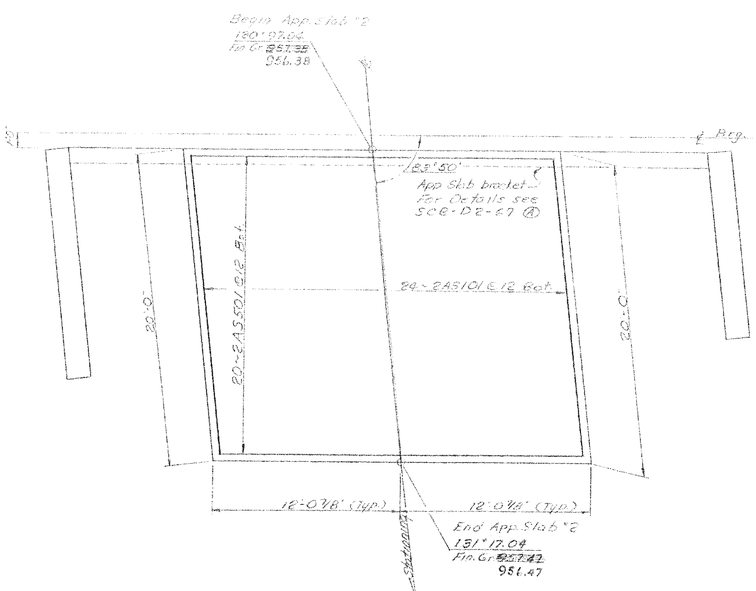

PLAN
1/8"=1'-0"

For Details of Reinforcing in the Curtain Wall See SCB-D2-67 (4)
Cut 5506 Bars as reqd.

STATEWIDE – N.E. REGION
BHF MEMB(19)
SHEET 30 OF 80
BRIDGE No. 97
FOR REFERENCE ONLY

STATE OF VERMONT
DEPARTMENT OF HIGHWAYS

PROJECT BLOOMFIELD
TOWN OF BLOOMFIELD
ROUTE No. VT 105 BTG. STA. 130+55
VT 105 OVER EAST BRANCH NULHEGAN RIVER
APPROACH SLAB DETAILS
SCALE AS NOTED
SECTION SUPERVISOR R. L. MERCHANT
DRAWN BY C. CORTAN CHECKED BY G. TUCKER
6/68
PROJECT NO. BB-039-3-6690
SHEET 26 OF 40 BR 107