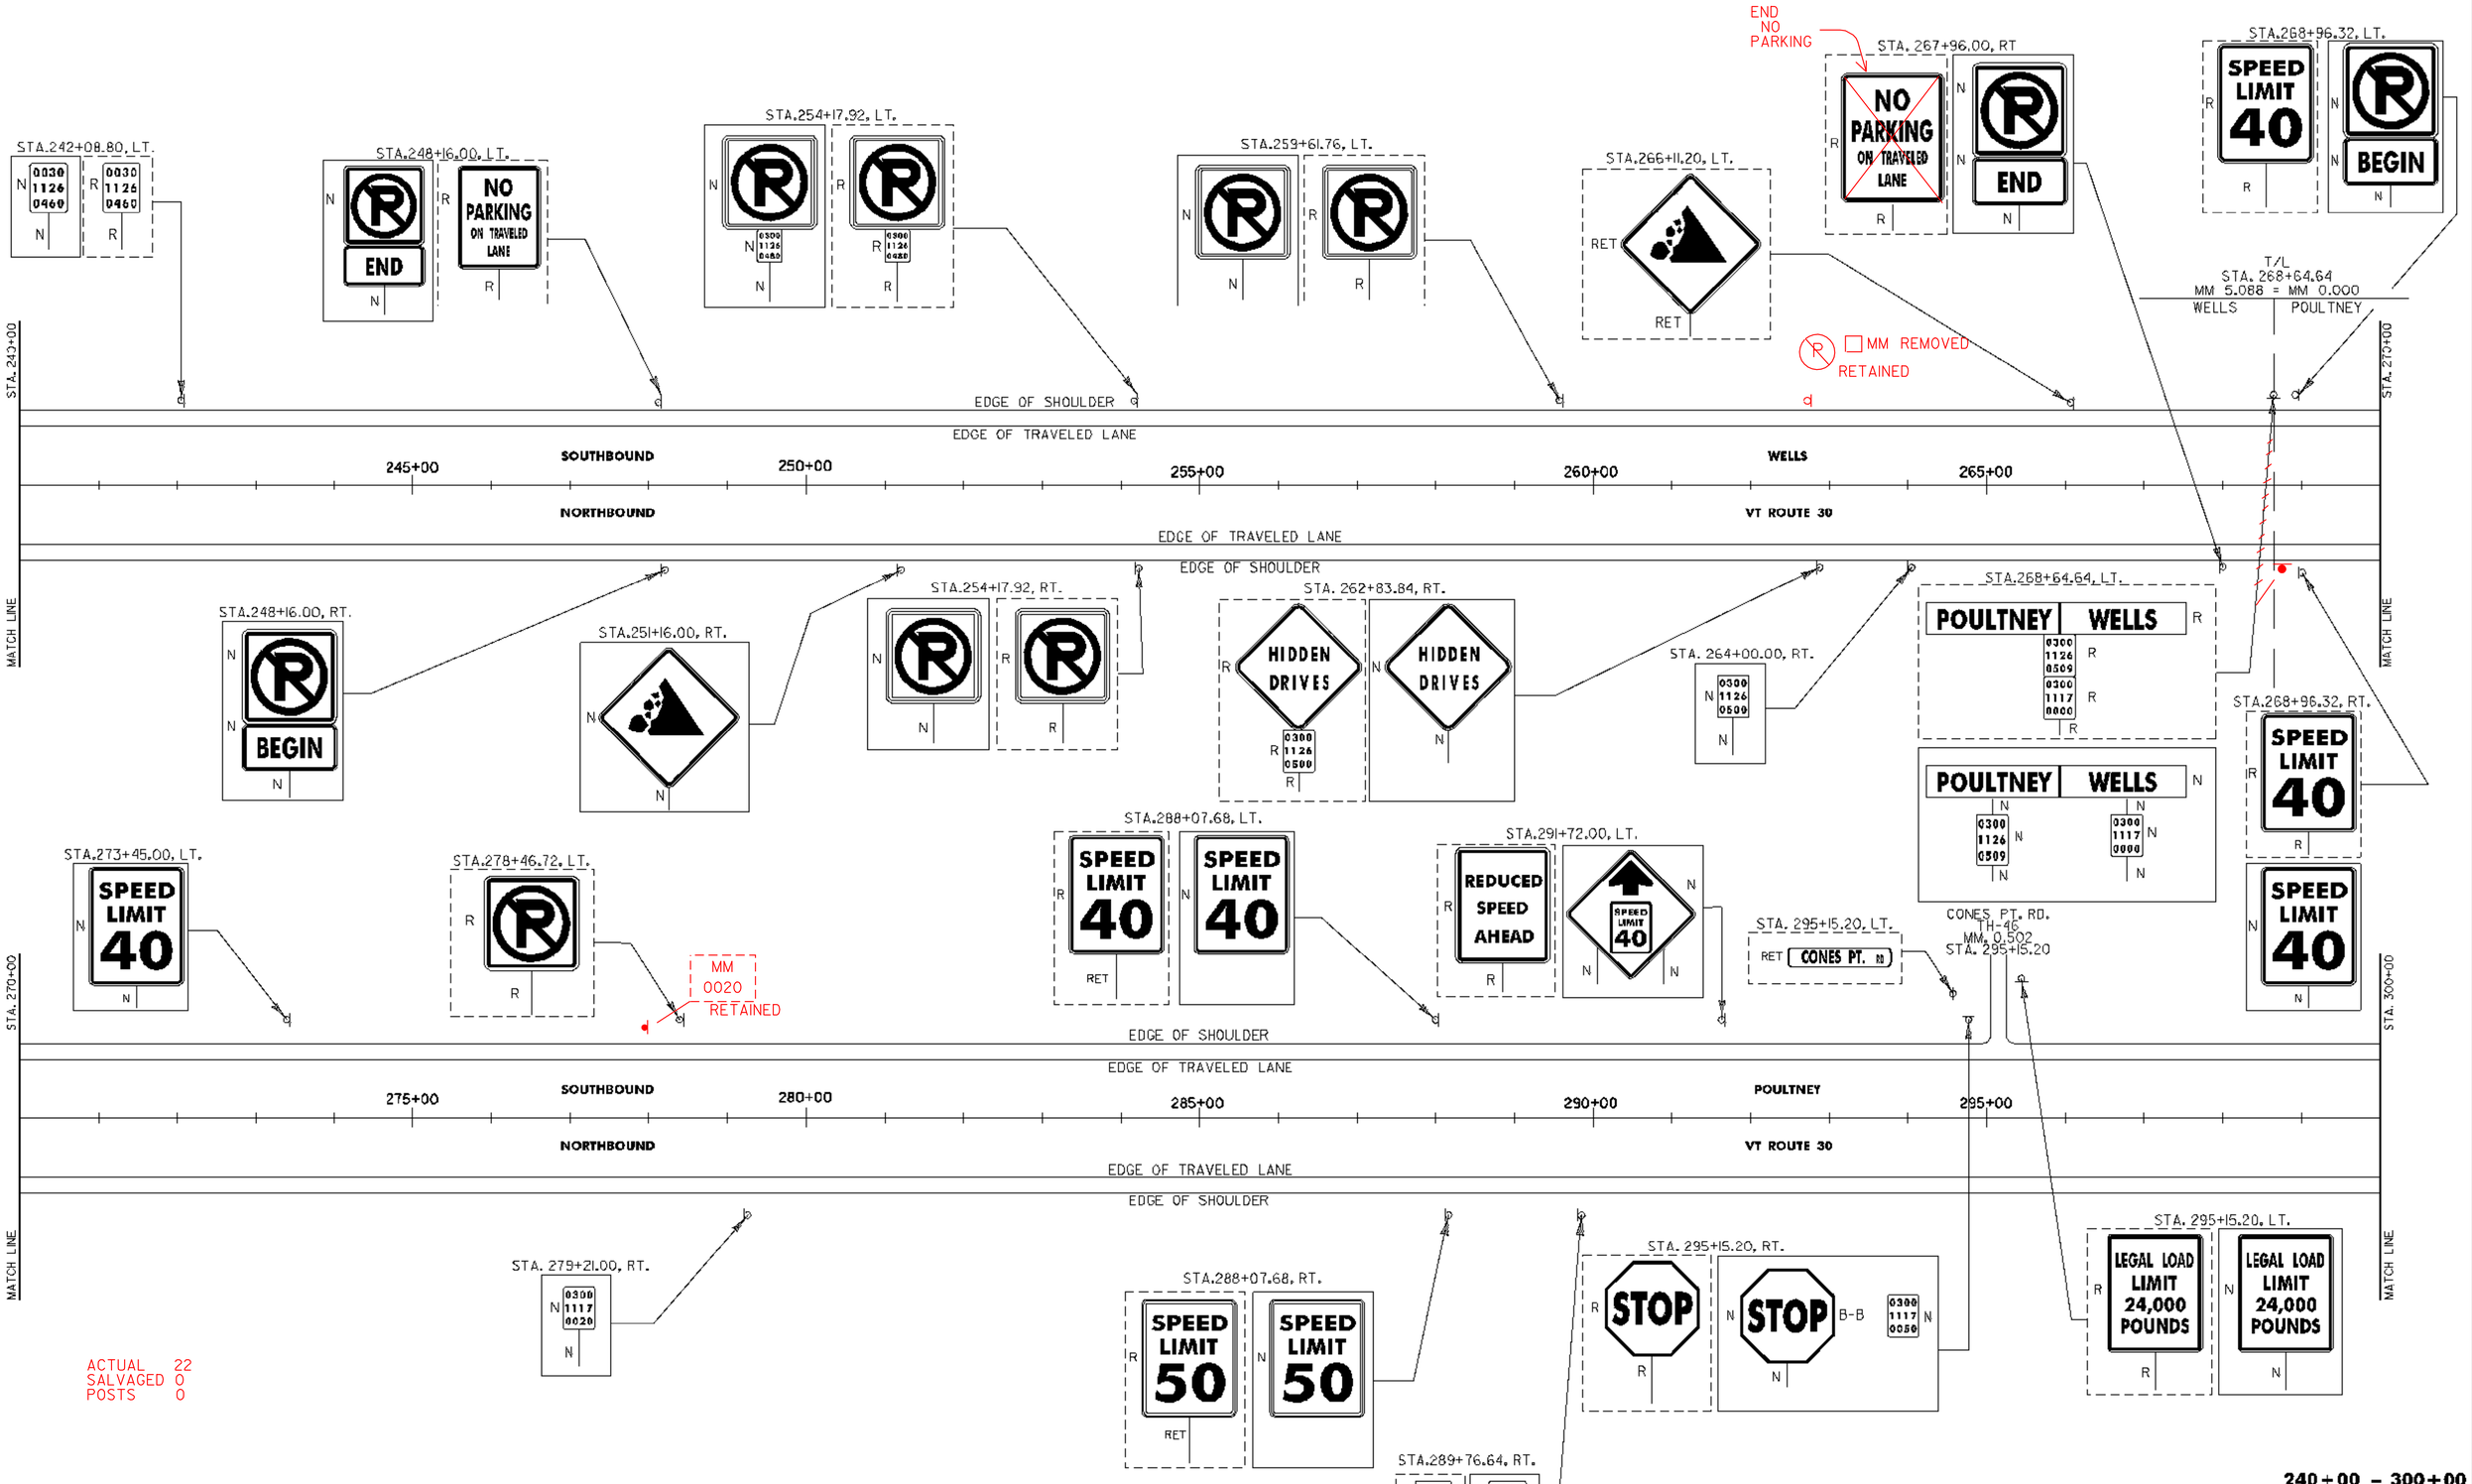

PROJECT NAME:	WELLS-HUBBARDTON
PROJECT NUMBER:	STPG SIGN (15)

FILE NAME: stpg sign15 plans.dgn	PLOT DATE: 04-AUG-2008
PROJECT LEADER: N. AVERY	DRAWN BY: ROADWAY
DESIGNED BY: N. AVERY	CHECKED BY: A. GAMBLE
SIGNING PLAN #6	SHEET 9 OF 75