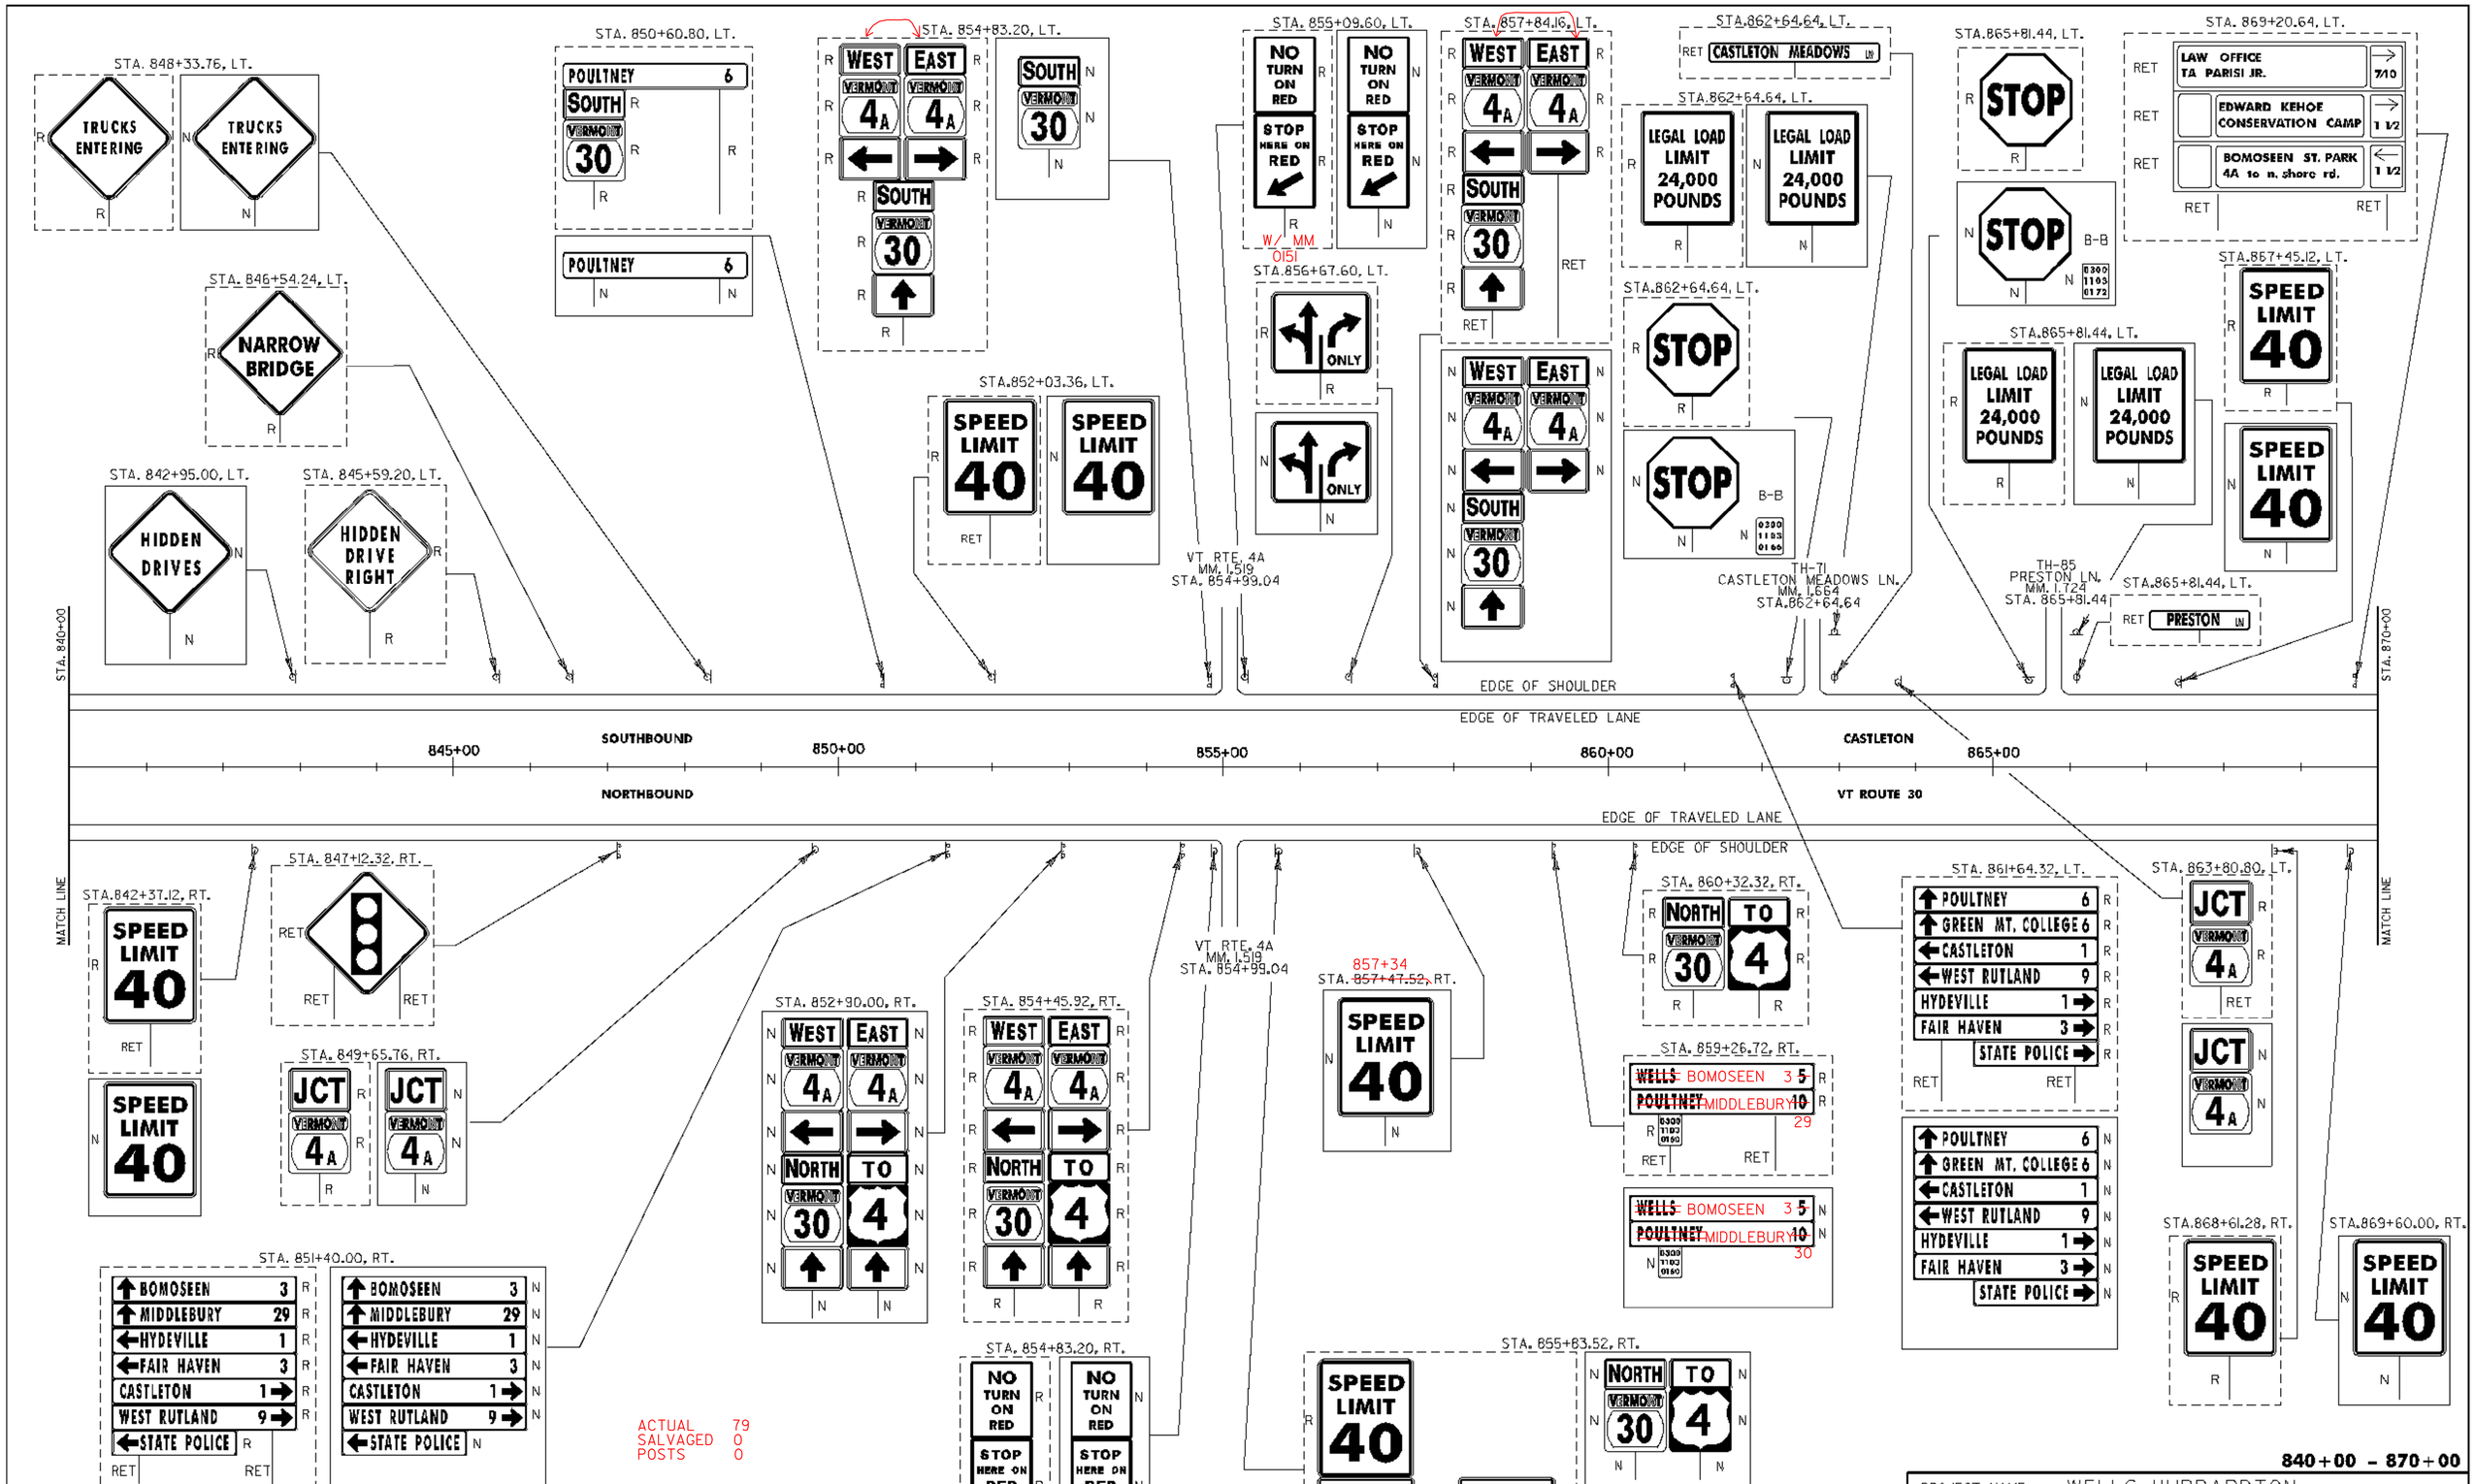

ACTUAL 79
SALVAGED 0
POSTS 0

840+00 - 870+00

SIGN LEGEND
R= REMOVE
S= SALVAGE
N= NEW
RET= RETAIN
B-B= BACK TO BACK
EXISTING= _____
NEW= _____

PROJECT NAME: WELLS-HUBBARDTON
PROJECT NUMBER: STPG SIGN (15)

FILE NAME: stpg sign15 plans.dgn
PROJECT LEADER: N. AVERY
DESIGNED BY: N. AVERY
SIGNING PLAN #16

PLOT DATE: 04-AUG-2008
DRAWN BY: ROADWAY
CHECKED BY: A. GAMBLE
SHEET 19 OF 75