STATE OF VERMONT
AGENCY OF TRANSPORTATION

TRAFFIC SIGN SUMMARY SHEET 11

MILEMARKER, STATION, OR SIGN NUMBER	SIGN LEGEND	SIGN DIMENSIONS EA	WIDTH (in)	HEIGHT (in)	NEW & SALVAGED SIGNS "A"	"B"	SALV SIGN	SALV TIS	EXIST POST RETAIN	SALVAGE	NEW SIGN POSTS NO. OF POSTS	FLANGED CHANNEL lb/ft 1.12	2.0	3.0	SQUARE STEEL (in) lb/ft 2.0 2.16	2.0 2.42	2.5 3.35	ANCHOR	SLEEVE	TUBULAR ALUMINUM Ø (in) lb/ft 3.0 1.3	4.0 1.7	4.0 MOD 1.7	FOUND-ATION	TUBULAR STEEL Ø (in) lb/ft 3.0 7.6	3.5 9.0	4.0 10.8	5.0 14.6	W-SHAPE STEEL FTG. SIZE 24"	30"	WEIGHT	POST SIZE	SIGN REFRAME REQUIRED	REMARKS	SIGN DETAIL DETAIL ON SHEET NUMBER	STD. SHEET NUMBER
												OPTION ITEMS																								
STA.291+72.00, LT.		1	36	36	9.00						2					14.25 X 14.17																		W3-5		
STA. 295+15.20, LT.	B-B *	1 1	30 6	30 10	6.25 0.42 × 2 = 0.84						1					X 13.33							* MILE INCORRECT ON PLANS, NEW SIGN NEEDED TO REPLACE ORIG. ORDERED AND INSTALLED SIGN												R1-1		E-143
STA. 295+15.20, LT.		1	24	30	5.00						1					X 13.50																		VR-017 VR-700		E-141 E-138
STA.300+22.08, LT.		1 1	30 30	30 8	6.25 1.67				1							0																		W2-2M W16-8A	31	E-155
STA.300+43.20, RT.		1	6	10	0.42						1					X 9.0																		VD-700		E-138
STA.309+88.32, LT.		1	6	10	0.42						1					X 10.0																		VD-700		E-138
STA.320+44.32, LT.		1	6	10	0.42						1					X 9.0																		VD-700		E-138
STA. 324+61.44, RT.		1	24	30	5.00						1					X 14.67																		VR-017		E-141
STA. 324+61.44, RT.	B-B	1 1	30 6	30 10	6.25 0.42						1					X 13.50																		RI-1 VD-700		E-143 E-138
STA.325+67.04, RT.	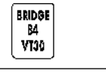	1	6	8	0.33						1					X 9.0																		VD-701		E-134
STA.326+51.52, LT.	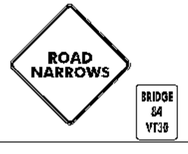	1 1	30 6	30 8	6.25 0.33						1					X 14.0																		W5-1 VD-701		E-154 E-134
												FT	FT	FT	FT	FT ~~165~~	FT		EA	LB	LB	LB		LB	LB	LB	LB								
TOTALS					SF ~~48.43~~ 48.85	SF	EA.	SF				FT			FT ~~165~~ 134.42					LB			EA.	LB				EA.	EA.	LB					

FINAL POST LENGTHS ARE TO BE DETERMINED IN THE FIELD. POST SIZES ARE COMPUTED BASED ON INFORMATION FURNISHED ON THE STANDARD SHEETS AND THE TRAFFIC & SAFETY DIVISION'S "SIGN POST DESIGN GUIDELINE."

PROJECT NAME: WELLS-HUBBARDTON
PROJECT NUMBER: STPG SIGN (15)

FILE NAME: stpg sign15 sums.dgn
PROJECT LEADER: N.AVERY
DESIGNED BY: N.AVERY
TRAFFIC SIGN SUMMARY SHEET 11

PLOT DATE: 04-AUG-2008
DRAWN BY: ROADWAY
CHECKED BY: A.GAMBLE
SHEET 42 OF 75