STATE OF VERMONT
AGENCY OF TRANSPORTATION

TRAFFIC SIGN SUMMARY SHEET 29

MILEMARKER, STATION, OR SIGN NUMBER	SIGN LEGEND	SIGN DIMENSIONS EA	SIGN DIMENSIONS WIDTH (in)	SIGN DIMENSIONS HEIGHT (in)	NEW & SALVAGED SIGNS "A"	NEW & SALVAGED SIGNS "B"	NEW & SALVAGED SIGNS SALV SIGN	NEW & SALVAGED SIGNS SALV TIS	EXIST POST RETAIN	EXIST POST SALVAGE	NO. OF POSTS	NEW SIGN POSTS: FLANGED CHANNEL lb/ft 1.12	FLANGED CHANNEL lb/ft 2.0	FLANGED CHANNEL lb/ft 3.0	SQUARE STEEL (in) lb/ft 2.0 2.16	SQUARE STEEL (in) lb/ft 2.0 2.42	SQUARE STEEL (in) lb/ft 2.5 3.35	ANCHOR	SLEEVE	TUBULAR ALUMINUM Ø (in) lb/ft 3.0 1.3	TUBULAR ALUMINUM Ø (in) lb/ft 4.0 1.7	TUBULAR ALUMINUM Ø (in) lb/ft 4.0 MOD 1.7	FOUND-ATION	TUBULAR STEEL Ø (in) lb/ft 3.0 7.6	TUBULAR STEEL Ø (in) lb/ft 3.5 9.0	TUBULAR STEEL Ø (in) lb/ft 4.0 10.8	TUBULAR STEEL Ø (in) lb/ft 5.0 14.6	W-SHAPE STEEL FTG. SIZE 24"	W-SHAPE STEEL FTG. SIZE 30"	W-SHAPE STEEL WEIGHT	W-SHAPE STEEL POST SIZE	SIGN REQUIRED	REMARKS	SIGN DETAIL DETAIL ON SHEET NUMBER	SIGN DETAIL STD. SHEET NUMBER
												OPTION ITEMS																							
STA.882+49.92, RT.		1	36	36	9.00				2							0																		W12-2		E-155
STA.884+13.60, LT.		1	36	36	9.00						2					15.42 X 14.75																		W3-5		
STA.884+61.12, RT.		1 1 1 1	72 24 24 21	12 12 24 15	6.00 2.00 4.00 2.19						2					17.42 X 17.75																		D1-1A M3-4 M1-4 M5-1		E-123 E-136A E-136A E-136A
STA.885+35.04, LT.	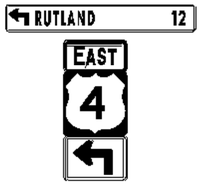	1 1 1 1	72 24 24 21	12 12 24 15	6.00 2.00 4.00 2.19						2					17.25 X 17.75																		D1-1A M3-2 M1-4 M5-1		E-123 E-136A E-136A E-136A
STA.886+19.52, RT.		1	30	30	6.25						1					X 14.08																		VR-92IL		E-145A
STA.887+30.40, LT.		1	36	36	9.00				2							0																		W12-2		E-155
												FT	FT	FT	FT	FT ~~105~~	FT		EA	LB	LB	LB		LB	LB	LB	LB								
FINAL POST LENGTHS ARE TO BE DETERMINED IN THE FIELD. POST SIZES ARE COMPUTED BASED ON INFORMATION FURNISHED ON THE STANDARD SHEETS AND THE TRAFFIC & SAFETY DIVISION'S "SIGN POST DESIGN GUIDELINE."																																			
	TOTALS				SF 61.63	SF	EA.	SF				FT				FT ~~105~~ 114.42				LB			EA.		LB				EA.	EA.	LB				

PROJECT NAME:	WELLS-HUBBARDTON
PROJECT NUMBER:	STPG SIGN (15)

FILE NAME: stpg sign15 sums.dgn	PLOT DATE: 04-AUG-2008
PROJECT LEADER: N.AVERY	DRAWN BY: ROADWAY
DESIGNED BY: N.AVERY	CHECKED BY: A.GAMBLE
TRAFFIC SIGN SUMMARY SHEET 29	SHEET 60 OF 75