STATE OF VERMONT
AGENCY OF TRANSPORTATION

TRAFFIC SIGN SUMMARY SHEET 31

MILEMARKER, STATION, OR SIGN NUMBER	SIGN LEGEND	SIGN DIMENSIONS EA	SIGN DIMENSIONS WIDTH (in)	SIGN DIMENSIONS HEIGHT (in)	NEW & SALVAGED SIGNS "A"	NEW & SALVAGED SIGNS "B"	NEW & SALVAGED SIGNS SALV SIGN	NEW & SALVAGED SIGNS SALV TIS	EXIST POST RETAIN	EXIST POST SALVAGE	NEW SIGN POSTS NO. OF POSTS	FLANGED CHANNEL lb/ft 1.12	FLANGED CHANNEL lb/ft 2.0	FLANGED CHANNEL lb/ft 3.0	SQUARE STEEL (in) lb/ft 2.0 2.16	SQUARE STEEL (in) lb/ft 2.0 2.42	SQUARE STEEL (in) lb/ft 2.5 3.35	ANCHOR	SLEEVE	TUBULAR ALUMINUM Ø (in) lb/ft 3.0 1.3	TUBULAR ALUMINUM Ø (in) lb/ft 4.0 1.7	TUBULAR ALUMINUM Ø (in) 4.0 MOD lb/ft 1.7	FOUND-ATION	TUBULAR STEEL Ø (in) lb/ft 3.0 7.6	TUBULAR STEEL Ø (in) lb/ft 3.5 9.0	TUBULAR STEEL Ø (in) lb/ft 4.0 10.8	TUBULAR STEEL Ø (in) lb/ft 5.0 14.6	W-SHAPE STEEL FTG. SIZE 24"	W-SHAPE STEEL FTG. SIZE 30"	W-SHAPE STEEL WEIGHT	W-SHAPE STEEL POST SIZE	SIGN FRAME REQUIRED	REMARKS	SIGN DETAIL DETAIL ON SHEET NUMBER	SIGN DETAIL STD. SHEET NUMBER
												OPTION ITEMS																							
STA.893+32.32, CTR	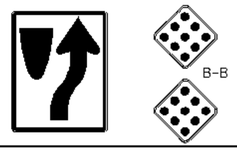 B-B	1 2	24 18	30 18	5.00 4.50				1							0																		R4-7 OMI-1 OMI-1		E-144 E-150 E-150
STA. 894+43.20, LT.		3	72	12	18.00						2					16.25 X 17.58																		DI-1A DI-1A DI-1A		E-123 E-123 E-123
STA. 894+80.16, RT.		1	72	20	10.00				2							0																		DI-1E(L)		E-123
STA.896+12.16, LT.		1	36	36	9.00						2					14.17 X 13.92																		W6-1		E-151
STA.896+96.64, LT.	B-B D300 1103 D231	1 1	30 6	30 10	6.25 0.42						1					X 13.0																		R1-1 VD-700		E-143 E-138
STA.896+96.64, LT.		1	24	30	5.00						1					X 13.33																		VR-017		E-141
STA. 899+97.60, LT.		1	72	20	10.00				2							0																		DI-1E(R)		E-123
STA. 901+97.60, LT.		1 1	21 24	15 24	2.19 4.00						1					X 14.83																		M2-1 M1-4		E-136A E-136A
STA.905+04.48, LT.		1	6	10	0.42				1							0																		VD-700		E-138
STA.912+06.72, LT.		1	6	10	0.42						1					X 9.50																		VD-700		E-138
												FT	FT	FT	FT	FT ~~120~~	FT		EA	LB	LB	LB		LB	LB	LB	LB								
TOTALS					SF 75.20	SF	EA.	SF				FT			FT ~~120~~ 112.58					LB			EA.	LB				EA.	EA.	LB					

FINAL POST LENGTHS ARE TO BE DETERMINED IN THE FIELD. POST SIZES ARE COMPUTED BASED ON INFORMATION FURNISHED ON THE STANDARD SHEETS AND THE TRAFFIC & SAFETY DIVISION'S "SIGN POST DESIGN GUIDELINE."

PROJECT NAME: WELLS-HUBBARDTON
PROJECT NUMBER: STPG SIGN (15)

FILE NAME: stpg sign15 sums.dgn
PROJECT LEADER: N.AVERY
DESIGNED BY: N.AVERY
TRAFFIC SIGN SUMMARY SHEET 31

PLOT DATE: 04-AUG-2008
DRAWN BY: ROADWAY
CHECKED BY: A.GAMBLE
SHEET 62 OF 75