STATE OF VERMONT
AGENCY OF TRANSPORTATION

TRAFFIC SIGN SUMMARY SHEET 37

MILEMARKER, STATION, OR SIGN NUMBER	SIGN LEGEND	SIGN DIMENSIONS EA	WIDTH (in)	HEIGHT (in)	NEW & SALVAGED SIGNS "A"	"B"	SALV SIGN	SALV TIS	EXIST POST RETAIN	SALVAGE	NEW SIGN POSTS NO. OF POSTS	FLANGED CHANNEL lb/ft 1.12	2.0	3.0	SQUARE STEEL (in) lb/ft 2.0 (2.16)	2.0 (2.42)	2.5 (3.35)	ANCHOR	SLEEVE	TUBULAR ALUMINUM Ø (in) lb/ft 3.0 (1.3)	4.0 (1.7)	4.0 MOD (1.7)	TUBULAR STEEL Ø (in) FOUND-ATION	lb/ft 3.0 (7.6)	3.5 (9.0)	4.0 (10.8)	5.0 (14.6)	W-SHAPE STEEL FTG. SIZE 24"	30"	WEIGHT	POST SIZE	REFRAMED SIGN	REMARKS	SIGN DETAIL DETAIL ON SHEET NUMBER	STD. SHEET NUMBER
												OPTION ITEMS																							
STA. 1120+41.60, RT.		1	30	30	6.25						1					X 13.58																	S3-1		E-153
STA. 1121+26.08, RT.	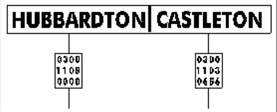	1 2	72 6	12 10	6.00 0.84						2					12.50 X 12.42																	VD-024 VD-700 VD-700		E-124 E-138 E-138
STA. 1122+89.76, LT.		1 1	30 18	30 18	6.25 2.25						1					X 15.67																	W1-2L W13-1		E-151 E-155
STA. 1125+37.92, LT.		1	30	30	6.25						1					X 13.50																	S3-1		E-153
STA. 1142+01.12, LT.		1	6	10	0.42						1					X 11.0																	VD-700		E-138
STA. 1152+51.84, RT.		1	6	10	0.42						1					X 8.17																	VD-700		E-138
STA. 1163+50.00, RT.		1 1	30 18	30 18	6.25 2.25						1					X 15.50																	W1-2L W13-1	31	E-155
STA. 1174+06.00, RT.		1	6	10	0.42						1					X 9.42																	VD-700		E-138
												FT	FT	FT	FT	FT ~~135~~	FT		EA	LB	LB	LB		LB	LB	LB	LB								
	TOTALS				SF 37.60	SF	EA.	SF				FT			FT ~~135~~ 111.76					LB			EA.	LB				EA.	EA.	LB					

FINAL POST LENGTHS ARE TO BE DETERMINED IN THE FIELD. POST SIZES ARE COMPUTED BASED ON INFORMATION FURNISHED ON THE STANDARD SHEETS AND THE TRAFFIC & SAFETY DIVISION'S "SIGN POST DESIGN GUIDELINE."

PROJECT NAME: WELLS-HUBBARDTON
PROJECT NUMBER: STPG SIGN (15)

FILE NAME: stpg sign15 sums.dgn
PROJECT LEADER: N.AVERY
DESIGNED BY: N.AVERY
TRAFFIC SIGN SUMMARY SHEET 37

PLOT DATE: 04-AUG-2008
DRAWN BY: ROADWAY
CHECKED BY: A.GAMBLE
SHEET 68 OF 75