STATE OF VERMONT
AGENCY OF TRANSPORTATION

TRAFFIC SIGN SUMMARY SHEET 3

MILEMARKER, STATION, OR SIGN NUMBER	SIGN LEGEND	SIGN DIMENSIONS EA	WIDTH (in)	HEIGHT (in)	NEW & SALVAGED SIGNS "A"	"B"	SALV SIGN	SALV TIS	EXIST POST RETAIN	EXIST POST SALVAGE	NEW SIGN POSTS NO. OF POSTS	FLANGED CHANNEL lb/ft 1.12	FLANGED CHANNEL lb/ft 2.0	FLANGED CHANNEL lb/ft 3.0	SQUARE STEEL (in) 2.0 lb/ft 2.16	SQUARE STEEL (in) 2.0 lb/ft 2.42	SQUARE STEEL (in) 2.5 lb/ft 3.35	ANCHOR	SLEEVE	TUBULAR ALUMINUM Ø (in) 3.0 lb/ft 1.3	TUBULAR ALUMINUM Ø (in) 4.0 lb/ft 1.7	TUBULAR ALUMINUM Ø (in) 4.0 MOD lb/ft 1.7	FOUNDATION	TUBULAR STEEL Ø (in) 3.0 lb/ft 7.6	TUBULAR STEEL Ø (in) 3.5 lb/ft 9.0	TUBULAR STEEL Ø (in) 4.0 lb/ft 10.8	TUBULAR STEEL Ø (in) 5.0 lb/ft 14.6	W-SHAPE STEEL FTG. SIZE 24"	W-SHAPE STEEL FTG. SIZE 30"	W-SHAPE STEEL WEIGHT	W-SHAPE STEEL POST SIZE	SIGN FRAME REQUIRED	REMARKS	SIGN DETAIL DETAIL ON SHEET NUMBER	SIGN DETAIL STD. SHEET NUMBER
												OPTION ITEMS																									
STA. 98+90.0, LT.		1	36	36	9.00						2					X		X															W2-6		SHSM
		1	36	36	9.00																											W3-2		SHSM
		1	18	18	2.25																											W13-1		SHSM
STA. 99+01.1, RT.		1	24	12	2.00						1					X		X														M3-2		SHSM
		1	24	24	4.00																										X	MI-6A		E-136B
STA. 99+01.1, RT.		1	24	12	2.00						1					X		X														M3-1 MOUNT TO PREVIOUS SIGN USING ROUTE MARKER ASSEMBLY FRAME (E-123)		SHSM
		1	30	24	5.00																											MI-6B		E-136B
STA. 99+79.4, RT.	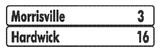	1	72	12	6.00						2					X		X															44	E-123
		1	72	12	6.00																												44	E-123
STA. ~~100+70.0, LT.~~ 102+45	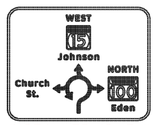 INSTALLED 12-13-11	1	144	114		114.00					2																			2		~~221~~ 285 lbs (19'-0") 247.5 lbs (16'-6")	W 6x15		GS-2	44	
STA. 101+24.5, RT.		1	24	30	5.00						1					X		X															R2-1		SHSM
STA. ~~102+50.0, LT.~~ 103+50 +/-	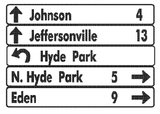	1	72	12	6.00						2					X		X															44	E-123
		1	72	12	6.00																													E-123
		1	72	12	6.00																													
		1	72	12	6.00																													E-123
		1	72	12	6.00																													E-123
STA. 106+10.0, LT.		1	21	15	2.19						1					X		X														M2-1		SHSM
		1	30	24	5.00																											MI-6B		E-136B
VT ROUTE 100 STA. 40+67.3, LT.		1	36	36	9.00						1					X		X	X														R1-2		SHSM
STA. 40+75.7, LT.		1	36	36	9.00						1					X		X														R1-2		SHSM
TOTALS		SF 105.44	SF 114.00	EA	SF							FT	FT	FT	FT	FT 210	FT		EA 1	LB	LB	LB	EA	LB	LB	LB	LB	EA 2	EA	LB 221					

SHSM = 2010 FHWA'S STANDARD HIGHWAY SIGNS & MARKINGS

FINAL POST LENGTHS ARE TO BE DETERMINED IN THE FIELD. POST SIZES ARE COMPUTED BASED ON INFORMATION FURNISHED ON THE STANDARD SHEETS AND THE VTRANS "SIGN POST DESIGN GUIDELINE."

PROJECT NAME: HYDE PARK
PROJECT NUMBER: HES 030-2(23)

FILE NAME: t08b126frm.dgn
PROJECT LEADER: JLS
DESIGNED BY: MBL
TRAFFIC SIGN SUMMARY SHEET 3

PLOT DATE: 08-DEC-2010
DRAWN BY: MBL
CHECKED BY: JAD
SHEET 47 OF 100