STATE OF VERMONT
AGENCY OF TRANSPORTATION

# TRAFFIC SIGN SUMMARY SHEET 4

| MILEMARKER, STATION, OR SIGN NUMBER | SIGN LEGEND | SIGN DIMENSIONS EA | WIDTH (in) | HEIGHT (in) | NEW & SALVAGED SIGNS "A" | "B" | SALV SIGN | SALV TIS | EXIST POST RETAIN | EXIST POST SALVAGE | NEW SIGN POSTS NO. OF POSTS | FLANGED CHANNEL lb/ft 1.12 | 2.0 | 3.0 | SQUARE STEEL (in) lb/ft 2.0 2.16 | 2.0 2.42 | 2.5 3.35 | ANCHOR | SLEEVE | TUBULAR ALUMINUM Ø (in) lb/ft 3.0 1.3 | 4.0 1.7 | 4.0 MOD 1.7 | FOUND-ATION | TUBULAR STEEL Ø (in) lb/ft 3.0 7.6 | 3.5 9.0 | 4.0 10.8 | 5.0 14.6 | W-SHAPE STEEL FTG. SIZE 24" | 30" | WEIGHT | POST SIZE | SIGN FRAME REQUIRED | REMARKS | SIGN DETAIL DETAIL ON SHEET NUMBER | STD. SHEET NUMBER |
|---|---|---|---|---|---|---|---|---|---|---|---|---|---|---|---|---|---|---|---|---|---|---|---|---|---|---|---|---|---|---|---|---|---|---|---|
| | | | | | | | | | | | | OPTION ITEMS | | | | | | | | | | | | | | | | | | | | | | | | | |
| STA. 40+69.3, RT. | | 1 | 24 | 12 | 2.00 | | | | | | 1 | | | | | X | | X | X | | | | | | | | | | | | | | M3-1 | | SHSM |
| | | 1 | 30 | 24 | 5.00 | | | | | | | | | | | | | | | | | | | | | | | | | | | | MI-6A | | E-136B |
| | | 1 | 21 | 15 | 2.19 | | | | | | | | | | | | | | | | | | | | | | | | | | | | M6-2 | | SHSM |
| STA. 40+99.0, CL. | | 1 | 24 | 30 | 5.00 | | | | | | 1 | | | | | X | | X | X | | | | | | | | | | | | | | R4-7 | | SHSM |
| | | 1 | 18 | 18 | 2.25 | | | | | | | | | | | | | | | | | | | | | | | | | | | | OMI-1 | | SHSM |
| STA. 41+85.0, LT. | 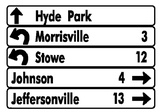 | 1 | 72 | 12 | 6.00 | | | | | | 2 | | | | | X | | X | | | | | | | | | | | | | | | | | E-123 |
| | | 1 | 72 | 12 | 6.00 | | | | | | | | | | | | | | | | | | | | | | | | | | | | | 44 | | |
| | | 1 | 72 | 12 | 6.00 | | | | | | | | | | | | | | | | | | | | | | | | | | | | | 44 | | |
| | | 1 | 72 | 12 | 6.00 | | | | | | | | | | | | | | | | | | | | | | | | | | | | | | E-123 | |
| | | 1 | 72 | 12 | 6.00 | | | | | | | | | | | | | | | | | | | | | | | | | | | | | | E-123 | |
| STA. 42+65.0, RT. | | 1 | 24 | 12 | 2.00 | | | | | | 1 | | | | | X | | X | | | | | | | | | | | | | | | M3-1 | | SHSM |
| | | 1 | 30 | 24 | 5.00 | | | | | | | | | | | | | | | | | | | | | | | | | | | | MI-6B | | E-136B |
| STA. 42+90.0, LT. | | 1 | 36 | 36 | 9.00 | | | | | | 2 | | | | | X | | X | | | | | | | | | | | | | | | W2-6 | | SHSM |
| | | 1 | 36 | 36 | 9.00 | | | | | | | | | | | | | | | | | | | | | | | | | | | | W3-2 | | SHSM |
| | | 1 | 18 | 18 | 2.25 | | | | | | | | | | | | | | | | | | | | | | | | | | | | WI3-1 | | SHSM |
| STA. 43+65.0, RT. | 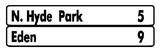 | 1 | 72 | 12 | 6.00 | | | | | | 2 | | | | | X | | X | | | | | | | | | | | | | | | | | E-123 |
| | | 1 | 72 | 12 | 6.00 | | | | | | | | | | | | | | | | | | | | | | | | | | | | | | E-123 | |
| STA. 44+65.0, LT. (APPROX.) | 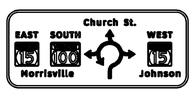 <br>INSTALLED 12-13-11 | 1 | 183 | 78 | | 99.13 | | | | 2 | | | | | | | | | | | | | | | | | | | 2 | | 243.75 lbs (16'-3")<br>~~240~~ W 6x15<br>288.75 lbs (19'-3") | | GS-3 | | 44 | |
| | | | | | | | | | | | | | | | | | | | | | | | | | | | | | | | | | | | |
| | | | | | | | | | | | | | | | | | | | | | | | | | | | | | | | | | | | |
| | | | | | | | | | | | | | | | | | | | | | | | | | | | | | | | | | | | |
| | | | | | SF | SF | EA | SF | | | | FT | FT | FT | FT | FT 135 | FT | | EA 2 | LB | LB | LB | | LB | LB | LB | LB | | | | | | | | |
| | | | | | 85.69 | 99.13 | | | | | | FT | | | FT 135 | | | | LB | | EA | LB | | | | | EA 2 | EA | LB 240 | | | | | |

SHSM = 2010 FHWA'S STANDARD HIGHWAY SIGNS & MARKINGS

FINAL POST LENGTHS ARE TO BE DETERMINED IN THE FIELD. POST SIZES ARE COMPUTED BASED ON INFORMATION FURNISHED ON THE STANDARD SHEETS AND THE VTRANS "SIGN POST DESIGN GUIDELINE."

**TOTALS**

PROJECT NAME: HYDE PARK
PROJECT NUMBER: HES 030-2(23)

FILE NAME: t08bl26frm.dgn
PROJECT LEADER: JLS
DESIGNED BY: MBL
TRAFFIC SIGN SUMMARY SHEET 4

PLOT DATE: 08-DEC-2010
DRAWN BY: MBL
CHECKED BY: JAD