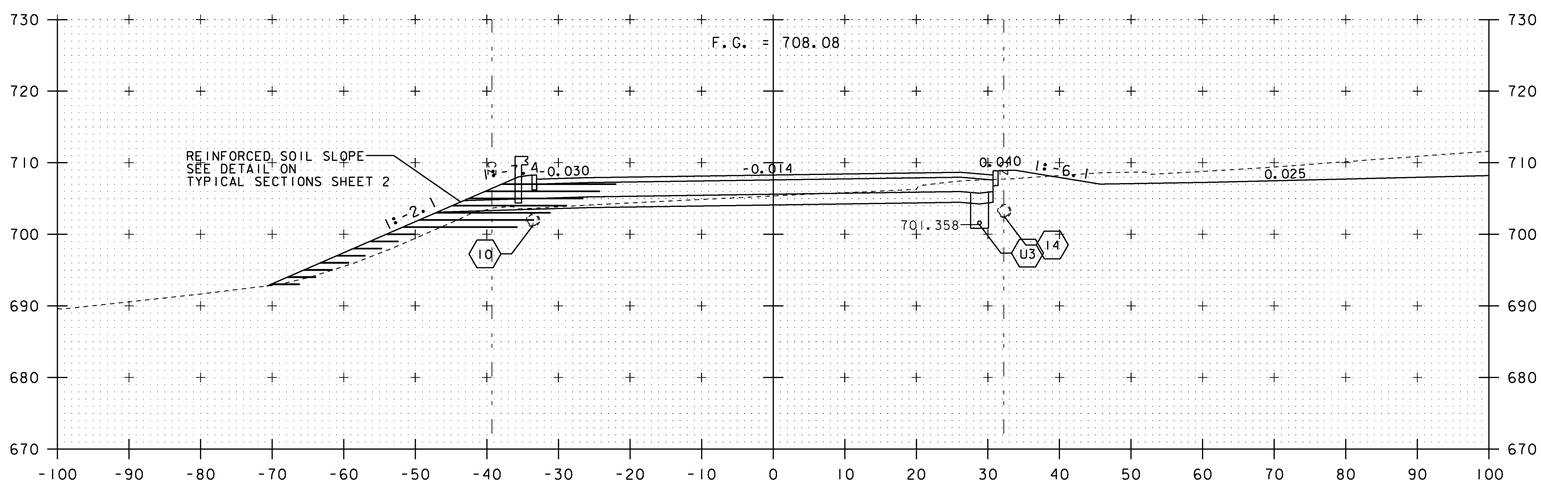

63+00

SCALES:
HORIZ: 1"=10'
VERT: 1"10'

T.H. 5 CHURCH ST.
STA. 63+00 TO STA. 63+00

PROJECT NAME: HYDE PARK
PROJECT NUMBER: HES 030-2(23)

FILE NAME: t08bl26xs.dgn
PROJECT LEADER: JLS
DESIGNED BY: MBL
CROSS SECTION SHEET 23

PLOT DATE: 08-DEC-2010
DRAWN BY: MBL
CHECKED BY: JAD
SHEET 100 OF 100