DURABLE 4 INCH WHITE LINE (SEE OPTION ITEMS)
STA. 134+75 - STA. 140+25 (SOLID LT & RT)
(WITH EDGELINE BREAKS AT TOWN ROADS)

DURABLE 4 INCH YELLOW LINE (SEE OPTION ITEMS)
STA. 134+75 - STA. 140+25 (SOLID LT & RT)
(WITH CENTERLINE BREAKS AT TOWN ROADS)
STA. 135+27 RT (CENTERLINE TH#1)
STA. 135+32 LT (CENTERLINE TH#3)

DURABLE 24 INCH STOP BAR (SEE OPTION ITEMS)
STA. 135+09 - STA. 135+31 LT
STA. 135+28 - STA. 135+48 RT

DURABLE LETTER OR SYMBOL (SEE OPTION ITEMS)
STA. 135+20 LT "STOP"
STA. 135+35 RT "STOP"
STA. 136+84 LT "SCHOOL"

TEMPORARY 4 INCH WHITE LINE, PAINT
STA. 134+75 - STA. 140+25 (SOLID LT & RT)
(WITH EDGELINE BREAKS AT TOWN ROADS)

TEMPORARY 4 INCH YELLOW LINE, PAINT
STA. 134+75 - STA. 140+25 (SOLID LT & RT)
(WITH CENTERLINE BREAKS AT TOWN ROADS)
STA. 135+27 RT (CENTERLINE TH#1)
STA. 135+32 LT (CENTERLINE TH#3)

TEMPORARY 24 INCH STOP BAR, PAINT
STA. 135+09 - STA. 135+31 LT
STA. 135+28 - STA. 135+48 RT

TEMPORARY LETTER OR SYMBOL, PAINT
STA. 135+20 LT "STOP"
STA. 135+35 RT "STOP"
STA. 136+84 LT "SCHOOL"

REMOVING SIGNS
AS SHOWN - 11

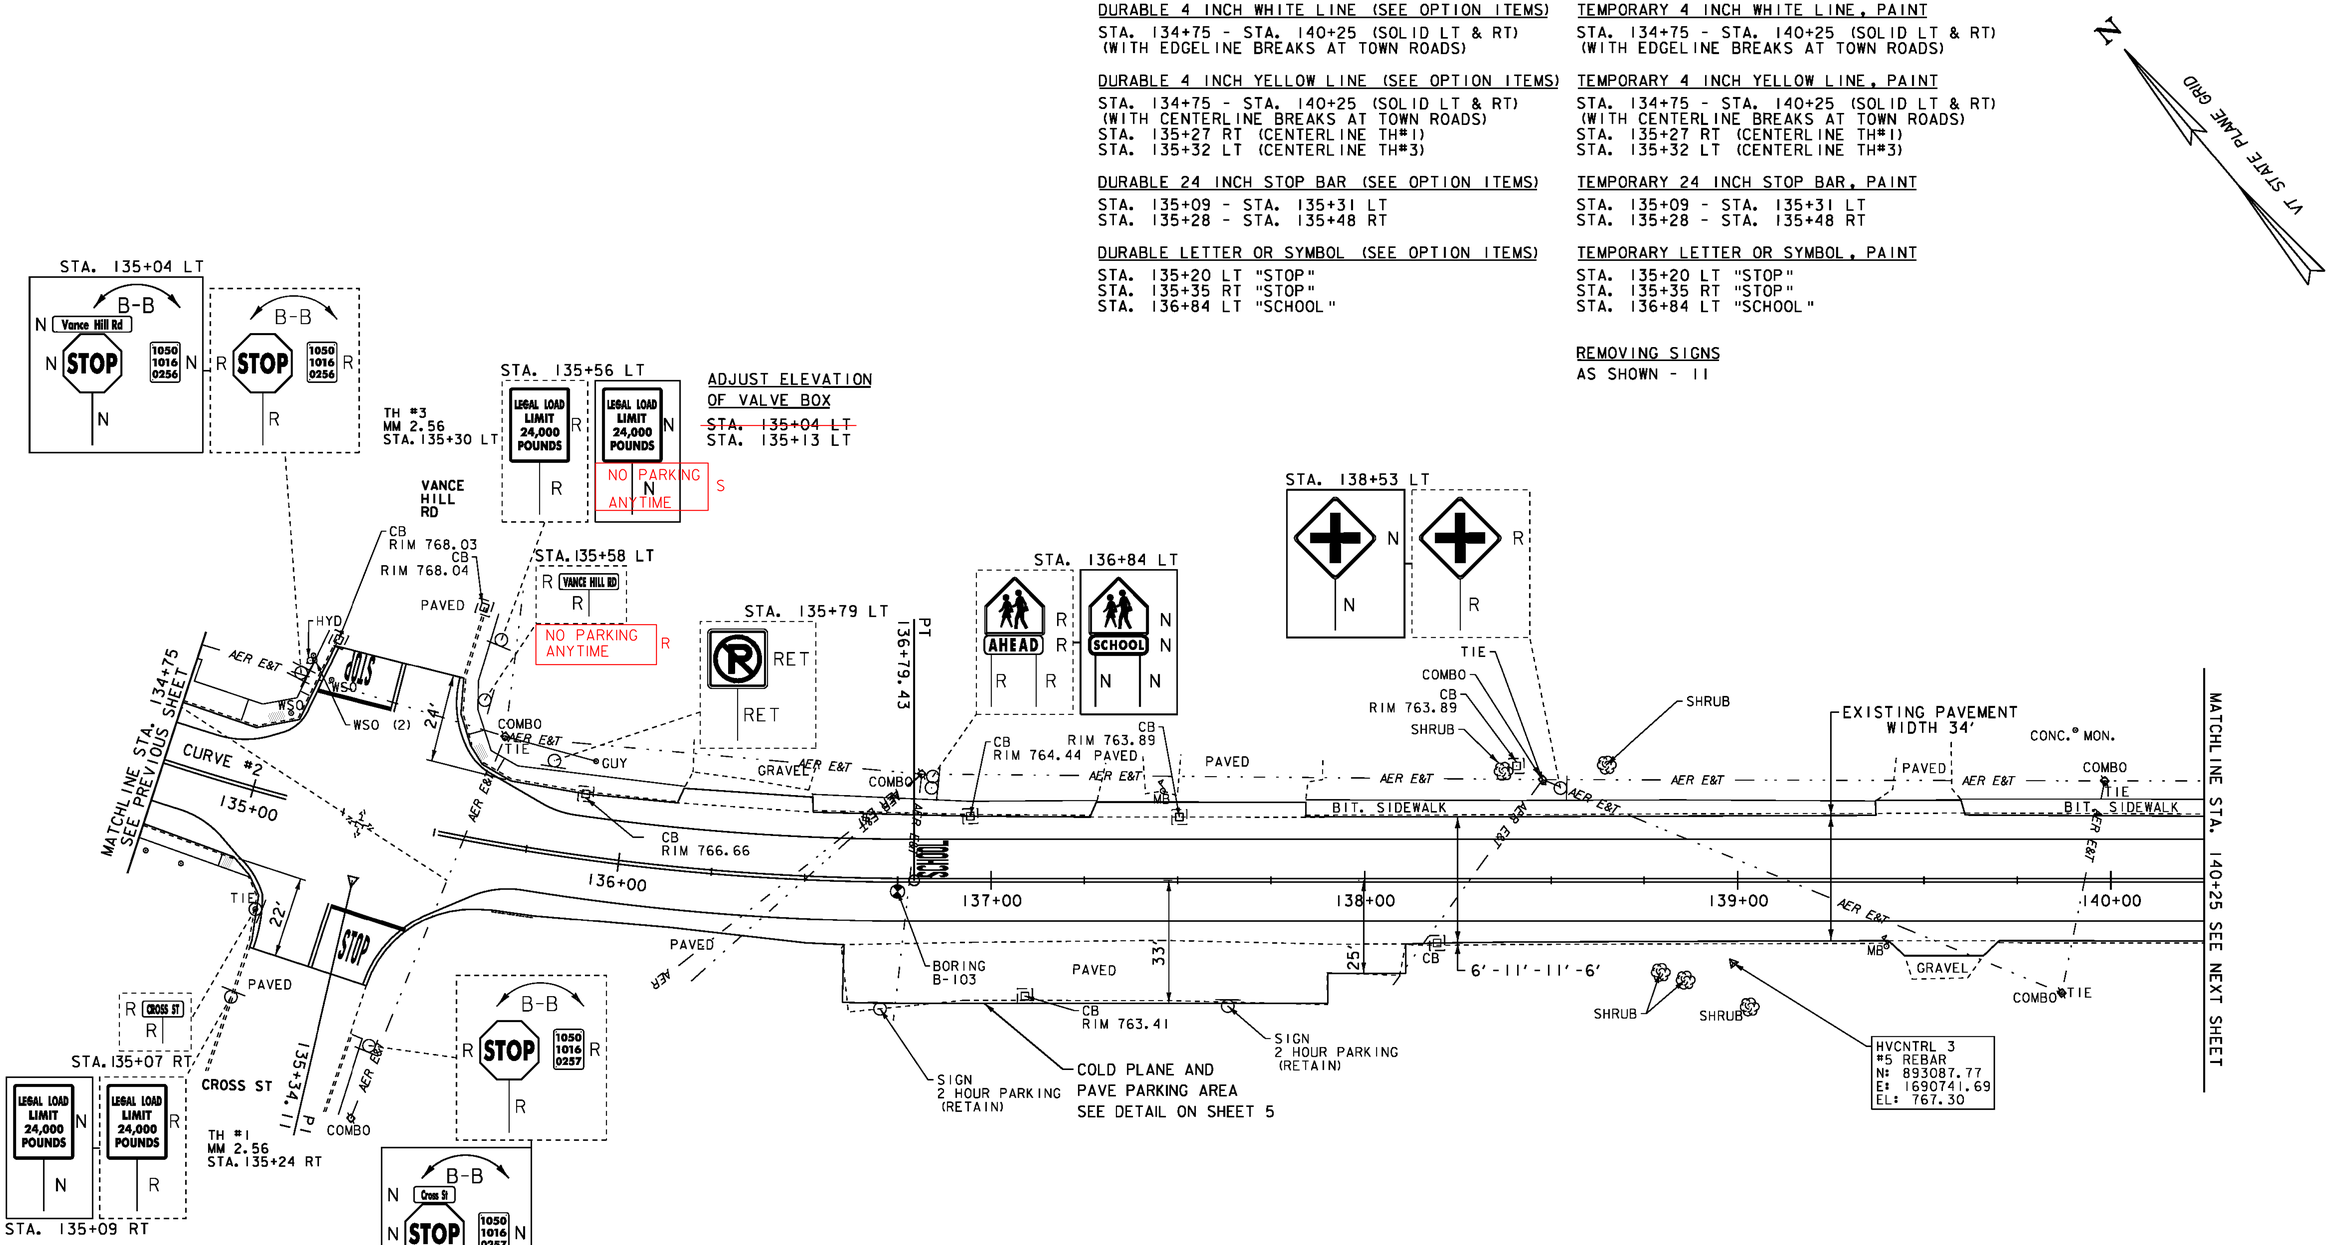

CURVE #2
DELTA = 26°04'40"
D = 8°48'53"
R = 650.00'
T = 150.53'
L = 295.84'

REHAB, DROP INLETS, CATCH BASINS, OR MANHOLES, CLASS I OR CLASS II

STA. 135+89 LT
STA. 136+94 LT
STA. 137+09 RT
STA. 137+51 LT
STA. 138+20 RT
VANCE HILL RD.

LEGEND

MAILBOX		MANHOLE		CURB INLET	
BORING		WATER SHUT OFF (WSO)		TRAFFIC CONTROL BOX	
SIGN		GAS PIPELINE MARKER		PARKING METER	
HYDRANT		CATCH BASIN / DROP INLET		UTILITY POLE	

SIGN LEGEND
R = REMOVE
R&S = REMOVE AND SALVAGE
RET = RETAIN
S = SALVAGE
N = NEW
B-B = BACK TO BACK

SCALE 1" = 20'-0
20 0 20

DATUM
NAVD 88
NAD 83

PROJECT LAYOUT SHEET 3

PROJECT NAME: NEWPORT-COVENTRY-NEWPORT
PROJECT NUMBER: STP 2802(1)

FILE NAME: 08b158.dgn
PROJECT LEADER: CDL
DESIGNED BY: BMB
PLOT FILE: 08b158-30.1
PLOT DATE: 8/2/2011
DRAWN BY: BMB
CHECKED BY: EPD
SHEET 30 OF 134