STATE OF VERMONT
AGENCY OF TRANSPORTATION

TRAFFIC SIGN SUMMARY SHEET 1

MILEMARKER, STATION, OR SIGN NUMBER	SIGN LEGEND	SIGN DIMENSIONS EA	WIDTH (in)	HEIGHT (in)	NEW & SALVAGED SIGNS "A"	"B"	SALV SIGN	SALV TIS	EXIST POST RETAIN	EXIST POST SALVAGE	NEW SIGN POSTS NO. OF POSTS	FLANGED CHANNEL lb/ft 1.12	2.0	3.0	SQUARE STEEL (in) 1.75 lb/ft 1.88	2.0 lb/ft 2.42	2.5 lb/ft 3.35	ANCHOR	SLEEVE	TUBULAR ALUMINUM Ø (in) 3.0 lb/ft 1.3	4.0 lb/ft 1.7	4.0 MOD lb/ft 1.7	FOUNDATION	TUBULAR STEEL Ø (in) 3.0 lb/ft 7.6	3.5 lb/ft 9.0	4.0 lb/ft 10.8	5.0 lb/ft 14.6	W-SHAPE STEEL FTG. SIZE 24"	30"	WEIGHT	POST SIZE	SIGN FRAMED	REMARKS SHS = FHWA STANDARD HIGHWAY SIGNS BOOK	SIGN DETAIL DETAIL IN SHS	DETAIL ON DWG. NUMBER	STD. SHEET NUMBER
STA. 126+04 RT NEWPORT									2																								RETAIN SIGN ON EXISTING POSTS			
		1	36	12	3.00																												S4-3 FLUORESCENT YELLOW-GREEN, TYPE IX SHEETING	SHS		
																																	RETAIN SIGN ON EXISTING POSTS			
STA. 129+58 RT NEWPORT		1	30	30	6.25						1					14.5' X		X															W2-1	SHS		
STA. 132+66 RT NEWPORT		1	30	30	6.25						1					14.25' X		X															W11-6H		128	
STA. 135+04 LT NEWPORT		1	36	12	3.00						1					13.75' X		X															D3-1		129	
	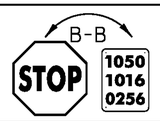	1 1	30 6	30 10	6.25 0.42																												R1-1 VD-700 MOUNT REFERENCE PLAQUE BACK-TO-BACK WITH STOP SIGN	SHS		E-138
FINAL POST LENGTHS ARE TO BE DETERMINED IN THE FIELD. POST SIZES ARE COMPUTED BASED ON INFORMATION FURNISHED ON THE STANDARD SHEETS AND THE VTRANS "SIGN POST DESIGN GUIDELINE."												LF	LF	LF	LF -	LF ~~45~~	LF		EA.	LB	LB	LB		LB	LB	LB	LB									
TOTALS					SF 25.17	SF	EA.	SF				LF			LF ~~45~~ 42.5					LB			EA.	LB				EA.	EA.	LB						

TRAFFIC SIGN SUMMARY SHEET 1

PROJECT NAME: NEWPORT-COVENTRY-NEWPORT
PROJECT NUMBER: STP 2802(I)

FILE NAME: 08bI58.dgn
PROJECT LEADER: CDL
DESIGNED BY: BMB
PLOT FILE: 08bI58-110.I

PLOT DATE: 8/3/2011
DRAWN BY: BMB
CHECKED BY: EPD
SHEET 110 OF 134