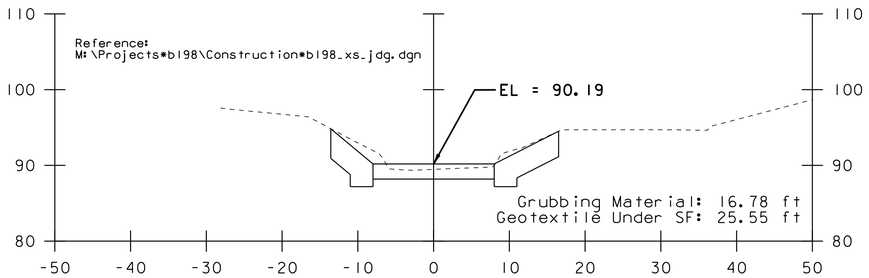

OUTLET
11+75

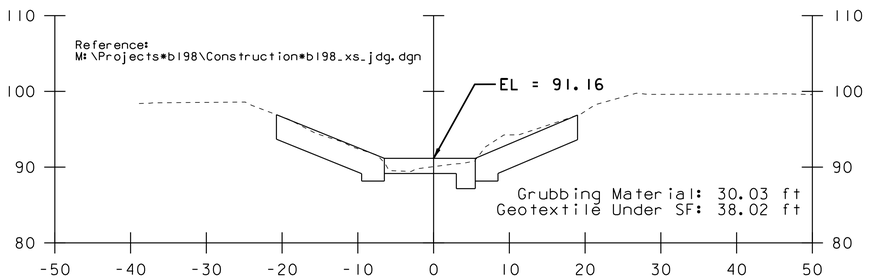

OUTLET
11+50

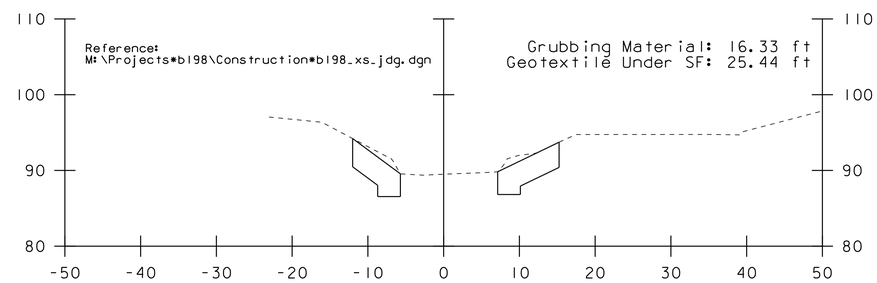

11+78
used for
12+30

CONTINUE STONE FILL TYPE III
TO STA. 11+90.00, MATCH EXISTING

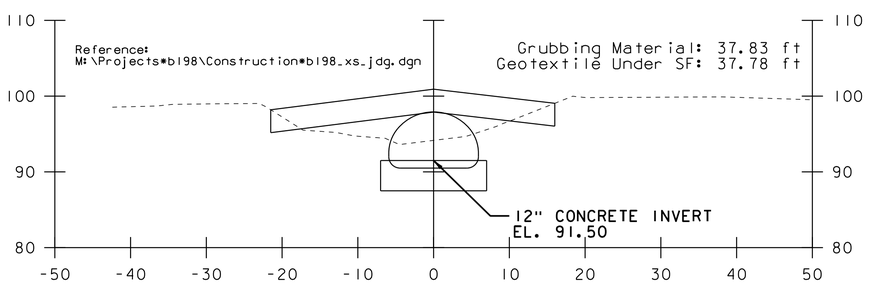

OUTLET
11+42

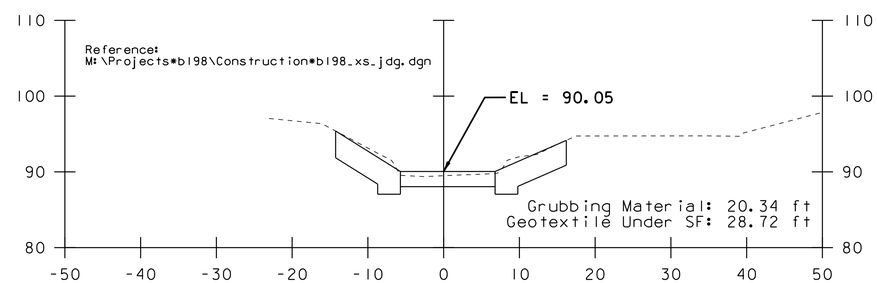

11+78
used for
11+94

STA. 11+42 TO STA. 11+78