TRAFFIC SIGN SUMMARY SHEET

MILEMARKER, STATION, OR SIGN NUMBER	SIGN LEGEND	SIGN DIMENSIONS EA	WIDTH (in)	HEIGHT (in)	NEW & SALVAGED SIGNS "A"	"B"	SALV SIGN	SALV TIS	EXIST POST RETAIN	SALVAGE	NEW SIGN POSTS NO. OF POSTS	FLANGED CHANNEL lb/ft 1.12	2.0	3.0	SQUARE STEEL (in) lb/ft 2.0 2.16	2.0 2.42	2.5 3.35	ANCHOR	SLEEVE	TUBULAR ALUMINUM Ø (in) lb/ft 3.0 1.3	4.0 1.7	4.0 MOD 1.7	TUBULAR STEEL Ø (in) FOUND-ATION	lb/ft 3.0 7.6	3.5 9.0	4.0 10.8	5.0 14.6	W-SHAPE STEEL FTG. SIZE 24"	30"	WEIGHT	POST SIZE	SIGN FRAME REQUIRED	REMARKS	SIGN DETAIL DETAIL ON SHEET NUMBER	STD. SHEET NUMBER
STA. 176+08.00, RT.	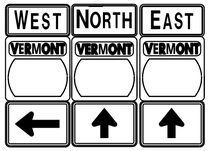	3 3 3	24 24 21	12 24 15	6.00 12.00 6.57				2																							#3	M3-4 M3-1 M3-2 MI-5 MI-5 MI-5 M6-1 M6-3 M6-3		E-123 E-136B E-136B E-136B
STA.177+12.00, LT.	RET STOP B-B	1 1	30 6	30 10	~~6.25~~ 0.42				1		~~1~~					~~X~~																	RI-1 VD-700	SHS	 E-138
STA. 178+31.00, RT.		2 2	24 24	12 24	4.00 8.00						2					16' 16'																#1	M3-1 M3-2 MI-5 MI-5		E-123 E-136B E-136B
STA. 178+62.00, LT.		2 2 2	24 24 21	12 24 15	4.00 8.00 4.38						2					4' 4'																#2	M3-1 M3-4 MI-5 M6-3		E-123 E-136B E-136B E-136B
STA. 181+21.00, LT.	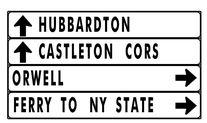	1 1 1 1	72 72 72 72	12 12 12 12	6.00 6.00 6.00 6.00				2																								DI-1A DI-1A DI-1A DI-1A		E-123 E-123 E-123 E-123
STA. 181+21.00, RT.		1	24	30	5.00						1					14'																	R2-1	SHS	
STA. 183+27.00, LT.		1 1	21 24	15 24	2.19 4.00						1					15'																	M2-1 MI-5		E-136B E-136B
STA.184+06.00, LT. 185+03 RT	STOP	1	24	30	5.00 6.25						1					16'																	VR-017		E-141
STA. 185+33.00, LT.		1	24	30	5.00						1					17'																	R2-1	SHS	
184+63 RT 184+83 RT	LLL 24,000 STOP/STREET SIGN/MM						1 1									X 4'																	SHS = STANDARD HIGHWAY SIGN BOOK		
												FT	FT	FT	FT	FT ~~135~~ 106	FT		EA	LB	LB	LB		LB	LB	LB	LB								
TOTALS					SF 104.81	SF	EA. 2	SF				FT			FT 106					LB			EA.	LB				EA.	EA.	LB					

FINAL POST LENGTHS ARE TO BE DETERMINED IN THE FIELD. POST SIZES ARE COMPUTED BASED ON INFORMATION FURNISHED ON THE STANDARD SHEETS AND VTRANS "SIGN POST DESIGN GUIDELINE."

PROJECT NAME: SUDBURY-MIDDLEBURY
PROJECT NUMBER: STPG SIGN (16)

FILE NAME: stpg sign16 sums.dgn
PROJECT LEADER: N.AVERY
DESIGNED BY: N.AVERY
TRAFFIC SIGN SUMMARY SHEET 5

PLOT DATE: 22-JUL-2014 16:49
DRAWN BY: ROADWAY
CHECKED BY: A.GAMBLE
SHEET 28 OF 45