TRAFFIC SIGN SUMMARY SHEET

MILEMARKER, STATION, OR SIGN NUMBER	SIGN LEGEND	SIGN DIMENSIONS EA	SIGN DIMENSIONS WIDTH (in)	SIGN DIMENSIONS HEIGHT (in)	NEW & SALVAGED SIGNS "A"	NEW & SALVAGED SIGNS "B"	NEW & SALVAGED SIGNS SALV SIGN	NEW & SALVAGED SIGNS SALV TIS	EXIST POST RETAIN	EXIST POST SALVAGE	NEW SIGN POSTS NO. OF POSTS	FLANGED CHANNEL lb/ft 1.12	FLANGED CHANNEL lb/ft 2.0	FLANGED CHANNEL lb/ft 3.0	SQUARE STEEL (in) lb/ft 2.0 2.16	SQUARE STEEL (in) lb/ft 2.0 2.42	SQUARE STEEL (in) lb/ft 2.5 3.35	ANCHOR	SLEEVE	TUBULAR ALUMINUM Ø (in) lb/ft 3.0 1.3	TUBULAR ALUMINUM Ø (in) lb/ft 4.0 1.7	TUBULAR ALUMINUM Ø (in) lb/ft 4.0 MOD 1.7	TUBULAR STEEL Ø (in) FOUND-ATION	TUBULAR STEEL Ø (in) lb/ft 3.0 7.6	TUBULAR STEEL Ø (in) lb/ft 3.5 9.0	TUBULAR STEEL Ø (in) lb/ft 4.0 10.8	TUBULAR STEEL Ø (in) lb/ft 5.0 14.6	W-SHAPE STEEL FTG. SIZE 24"	W-SHAPE STEEL FTG. SIZE 30"	W-SHAPE STEEL WEIGHT	W-SHAPE STEEL POST SIZE	SIGN FRAME REQUIRED	REMARKS	SIGN DETAIL DETAIL ON SHEET NUMBER	SIGN DETAIL STD. SHEET NUMBER
												OPTION ITEMS																							
STA.902+77.00, RT.		1	48	24	8.00						2					14′ X 15′																		WI-6	SHS	
STA.902+77.00, RT.		1	48	24	8.00						2					14′ X 15′																		WI-6	SHS	
STA.905+40.00, LT.		1	30	30	6.25						1					15′ X																		VW-054		E-154
STA.910+00.00, LT.		1 1	30 18	30 18	6.25						1					15′ X																		WI-2R WI3-1	SHS SHS	
STA.918+88.00, RT.		1 1	30 18	30 18	6.25						1					15′																		WI-2R WI3-1	SHS SHS	
STA. 914+65.00, RT.																11′																				
STA. 925+21.00, LT.																11′																				
STA.927+00.00, LT.		1 1	30 18	30 18	6.25						1					16′ X																		WI-2L WI3-1	SHS SHS	
STA. 933+61.00, RT.	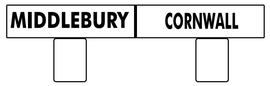	1 2	72 6	10 10	5.00 0.84						2					15′ 15′ X																		VD-024 VD-700	22	E-138
STA. 943+17.00, RT.																																			
																																		SHS = STANDARD HIGHWAY SIGN BOOK		
												FT	FT	FT	FT	FT ~~174~~ 183	FT		EA	LB	LB	LB		LB	LB	LB	LB								
TOTALS					SF 55.27	SF	EA.	SF				FT			FT 183					LB			EA.	LB				EA.	EA.	LB					

FINAL POST LENGTHS ARE TO BE DETERMINED IN THE FIELD. POST SIZES ARE COMPUTED BASED ON INFORMATION FURNISHED ON THE STANDARD SHEETS AND VTRANS "SIGN POST DESIGN GUIDELINE."

PROJECT NAME: SUDBURY-MIDDLEBURY
PROJECT NUMBER: STPG SIGN (16)

FILE NAME: stpg sign16 sums.dgn
PROJECT LEADER: N.AVERY
DESIGNED BY: N.AVERY
TRAFFIC SIGN SUMMARY SHEET 19

PLOT DATE: 22-JUL-2014 16:50
DRAWN BY: ROADWAY
CHECKED BY: A.GAMBLE
SHEET 42 OF 45