HIGHWAY FEDERAL AID SHEET
PLATE 3-FULL CROSS SECTION-FULL LINE
NATIONAL PRINTFAST
PRINTED IN U.S.A.

ORIGINAL SURVEY
NO.
NOTE BOOK
AREAS CHECKED
AREAS
TEMPLATE
PLOTTED
SURVEYED
BY
DATE

ZERO CHAN 2+50

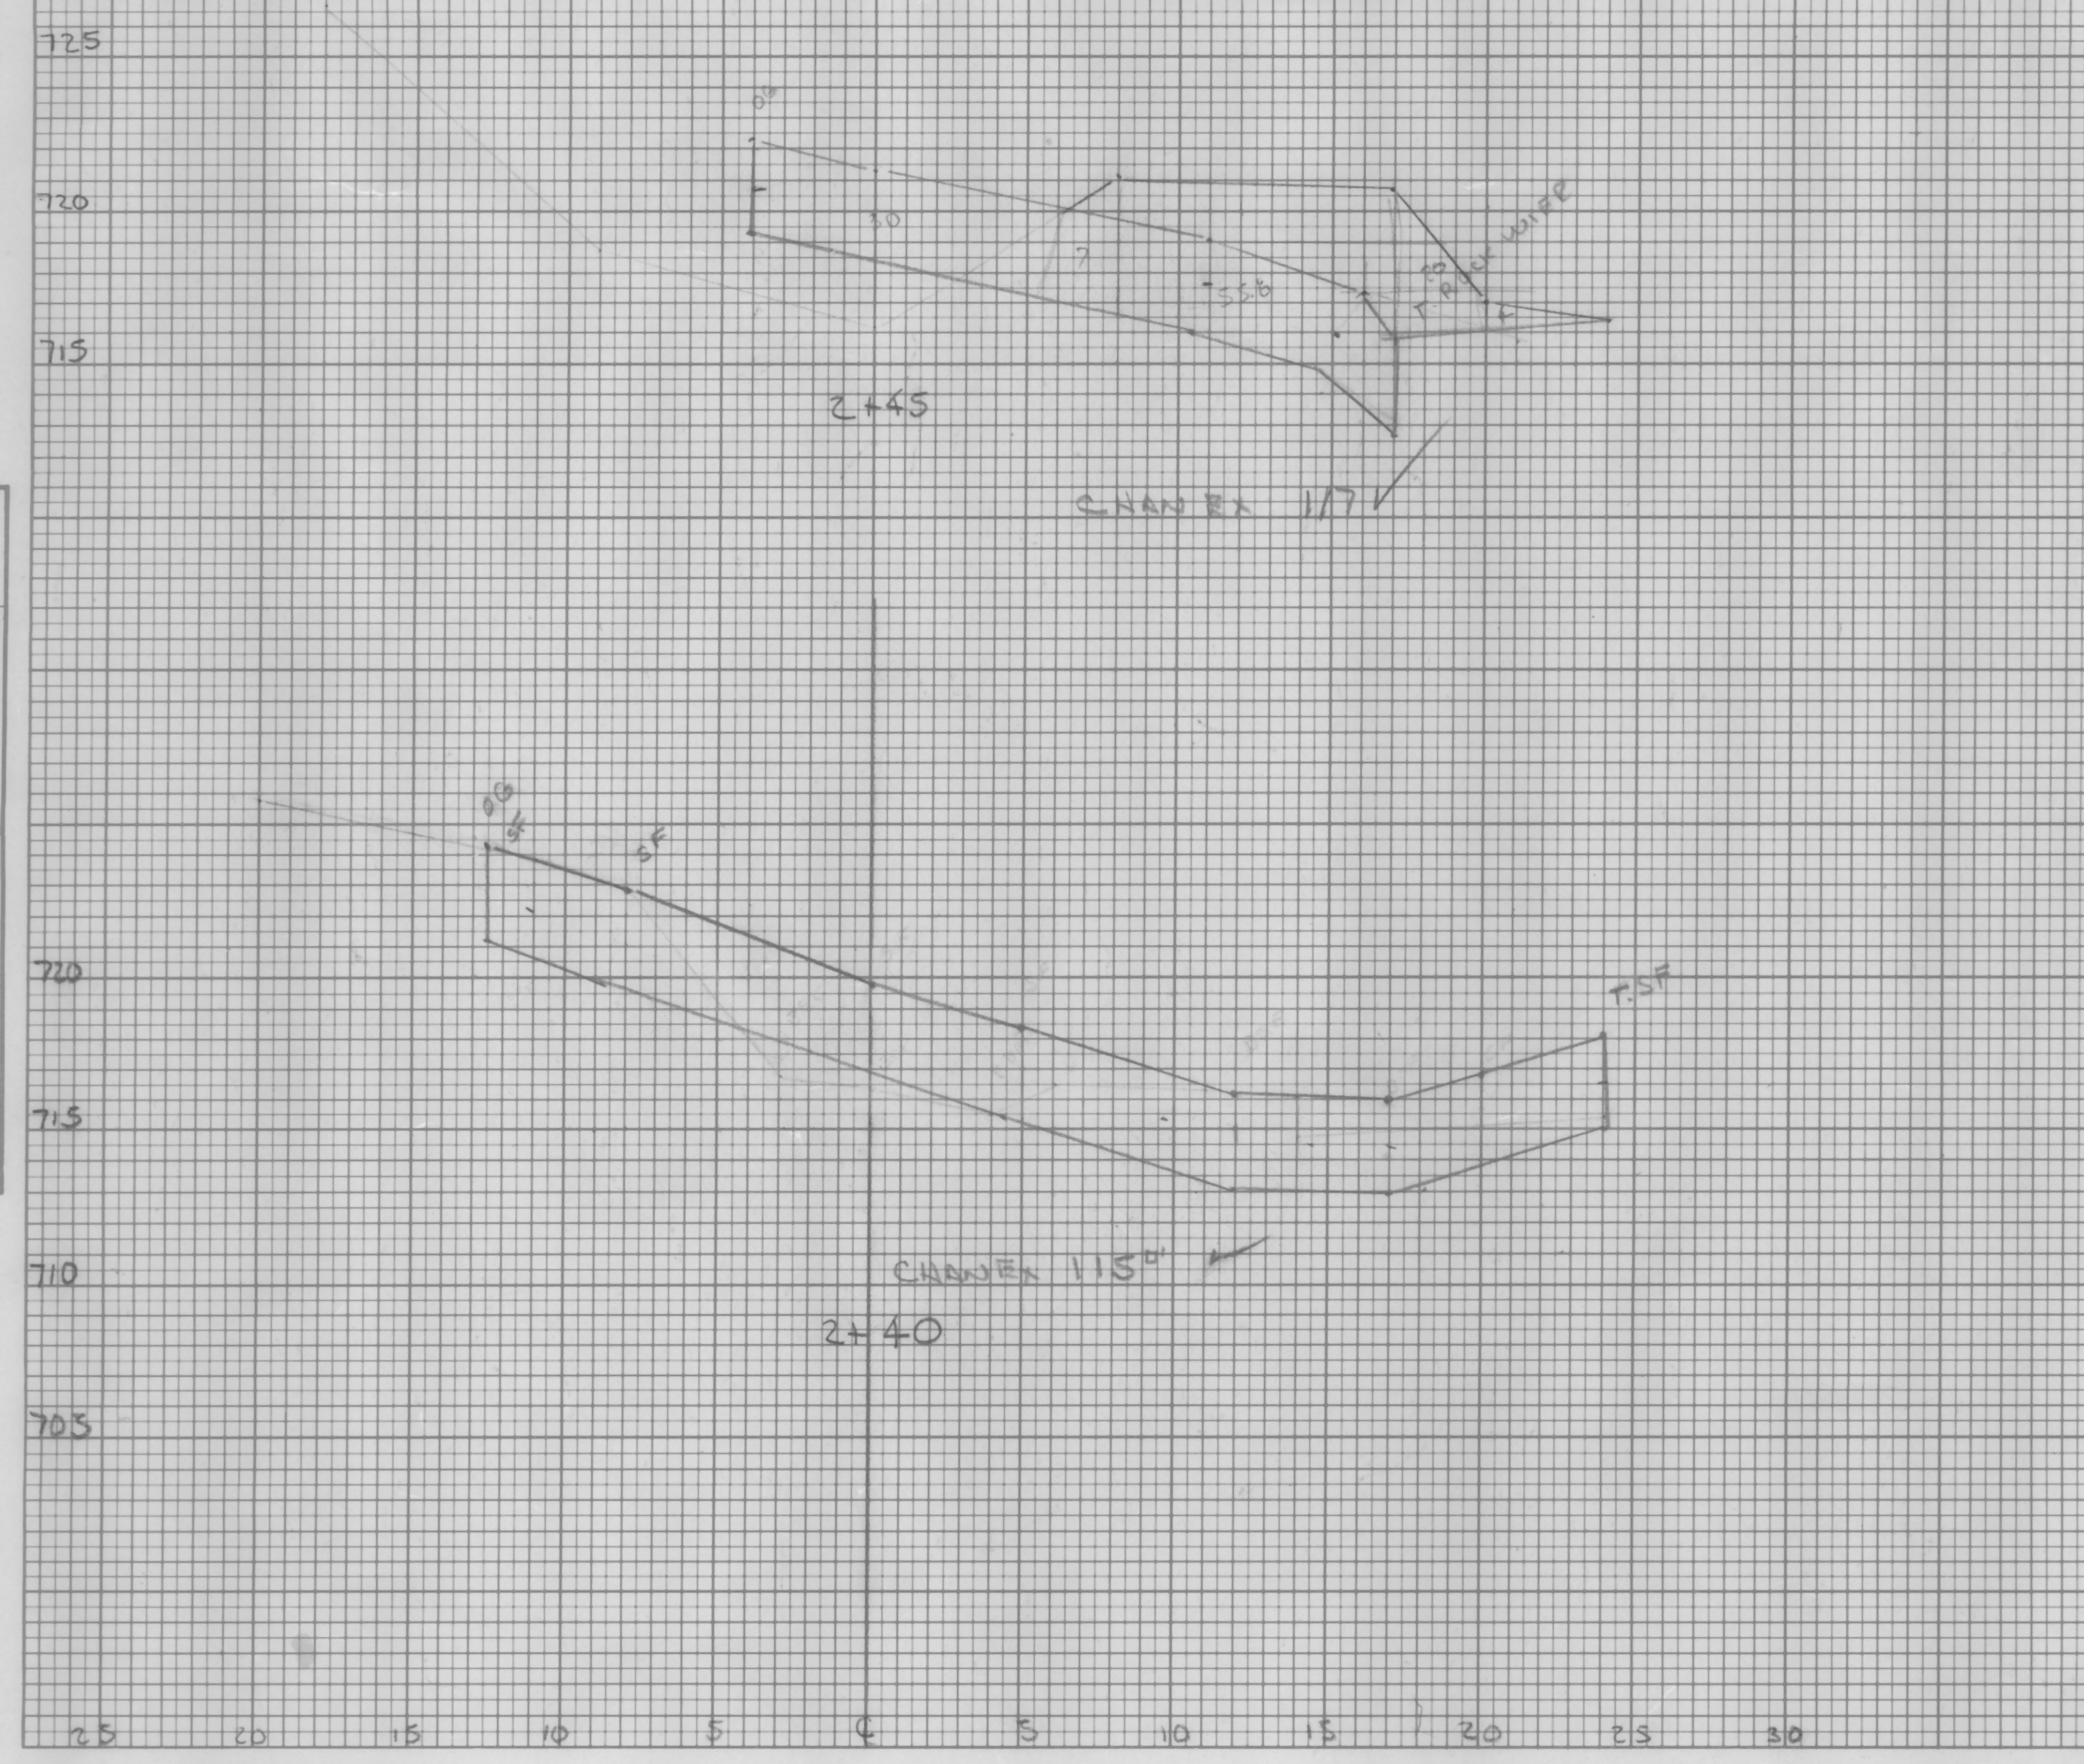

725
720
715
00
30
7
55.6
30
T. ROCK WIFE
2+45
CHAN EX 1/7
00
SF
SF
T.SF
720
715
710
705
CHAN EX 115'
2+40
25
20
15
10
5
℄
5
10
15
20
25
30

FINAL SURVEY
NO.
NOTE BOOK
AREAS CHECKED
AREAS
TEMPLATE
PLOTTED
SURVEYED
BY
DATE

✓ 2/10/10 DOJ

FAIR
CHA
2+4
[redacted]