646.402 DURABLE 4 INCH WHITE LINE, THERMOPLASTIC
(ALL LINES WILL INCLUDE EDGE LINE BREAKS AND RADIUS FOR TOWN HIGHWAYS)
RIPTON:
STA 37+00.00 - STA 50+00.00 EDGE LINE LT & RT

646.412 DURABLE 4 INCH YELLOW LINE, THERMOPLASTIC
(ALL LINES WILL INCLUDE C/L BREAKS FOR TOWN HIGHWAYS) S=SOLID, D=DASHED

RIPTON:	LT	℄	RT
STA 37+00.00 - STA 50+00.00	S	-	S

646.602 TEMPORARY 4 INCH WHITE LINE, PAINT
(ALL LINES WILL INCLUDE EDGE LINE BREAKS AND RADIUS FOR TOWN HIGHWAYS)
RIPTON:
STA 37+00.00 - STA 50+00.00 EDGE LINE LT & RT

646.612 TEMPORARY 4 INCH YELLOW LINE, PAINT
(ALL LINES WILL INCLUDE C/L BREAKS FOR TOWN HIGHWAYS) S=SOLID, D=DASHED

RIPTON:	LT	℄	RT
STA 37+00.00 - STA 50+00.00	S	-	S

675.50 REMOVING SIGNS
AS SHOWN - 20

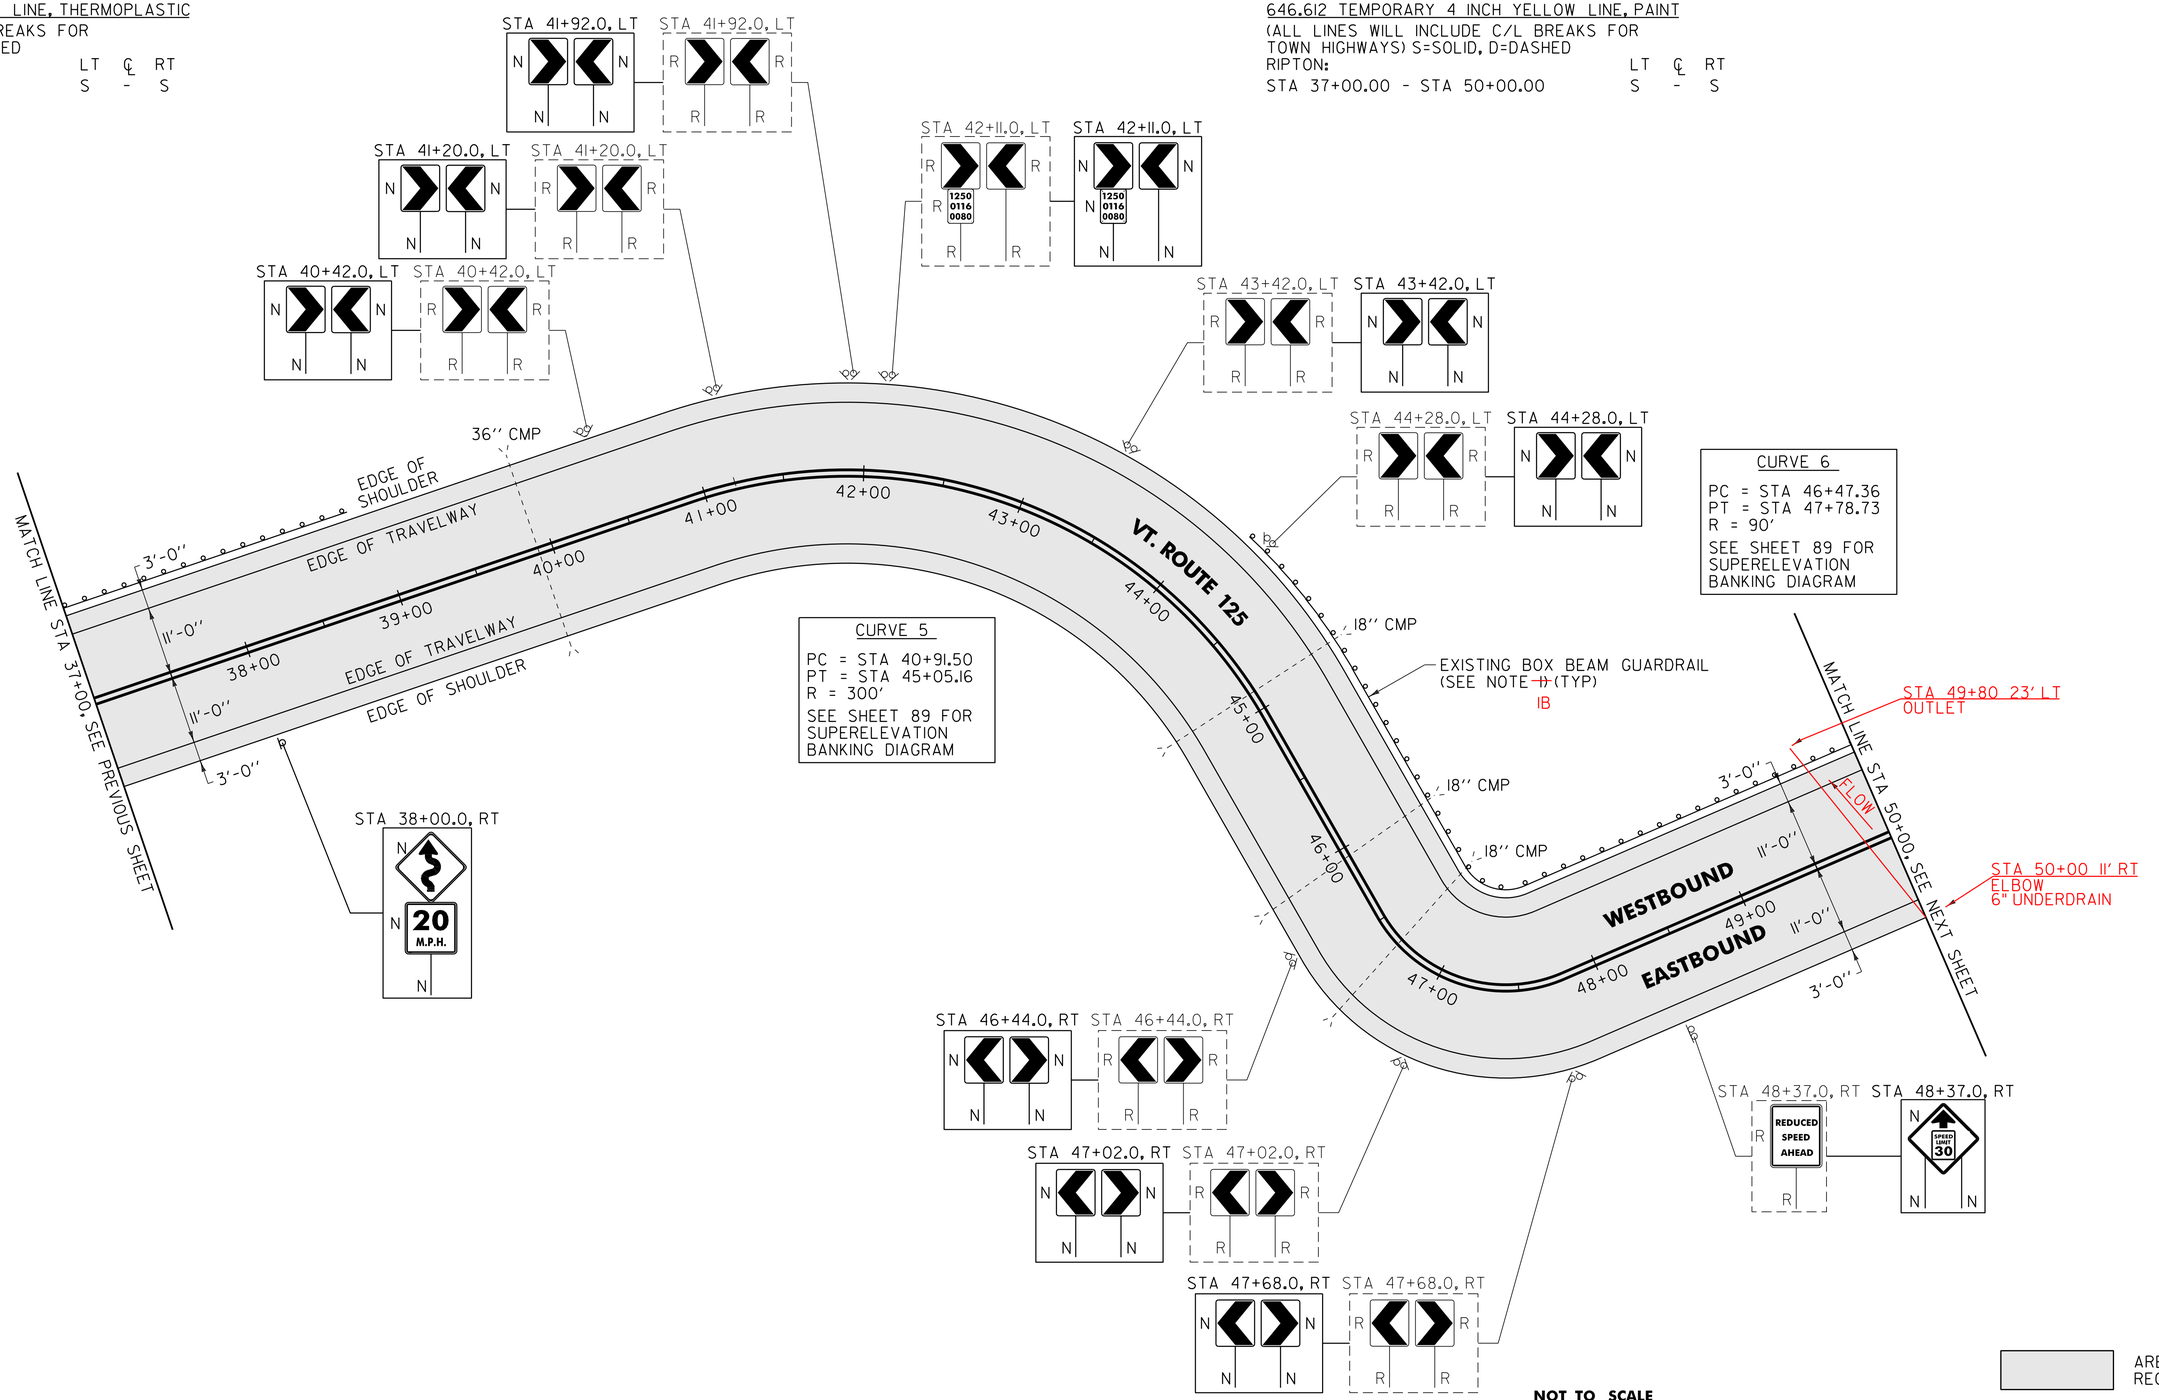

NOTES:
NOTE:

~~11. THE CONTRACTOR SHALL REPAIR AND/OR MAKE HEIGHT ALTERATIONS TO BOX BEAM GUARDRAIL AND/OR MAKE STANDARD BEAM TRANSITIONS AS DIRECTED BY THE RESIDENT ENGINEER. WORK SHALL BE PAID FOR UNDER ITEM 900.01 SPECIAL PROVISION BOX BEAM GUARDRAIL REPAIRS, WEATHERING. ALL ESTIMATED QUANTITIES FOR THIS ITEM HAS BEEN INCLUDED IN THE PLAN SET. SEE SHEET 9 FOR AVAILABLE BOX BEAM GUARDRAIL INVENTORY.~~

IB REFERENCE SHEET 31 OF 114 NOTE 1(B).
STA 37+00 LT TO 38+80 LT
STA 44+15 LT TO 50+00 LT

SIGN LEGEND
R = REMOVE
S = SALVAGE
N = NEW
RET = RETAIN
B-B = BACK TO BACK
EXISTING = - - - - - - -
NEW = ————

NOT TO SCALE

PROJECT LAYOUT SHEET #4

PROJECT NAME: RIPTON - HANCOCK
PROJECT NUMBER: STP 2803(1)

FILE NAME: p08c160.dgn
PROJECT LEADER: D.E.G.
DESIGNED BY: M.J.M.
IPARM FILE: p08c160104.i
PLOT DATE: 18-SEP-2013 17:10
DRAWN BY: C.A.K.
CHECKED BY: D.W.E.
SHEET 63 OF 114