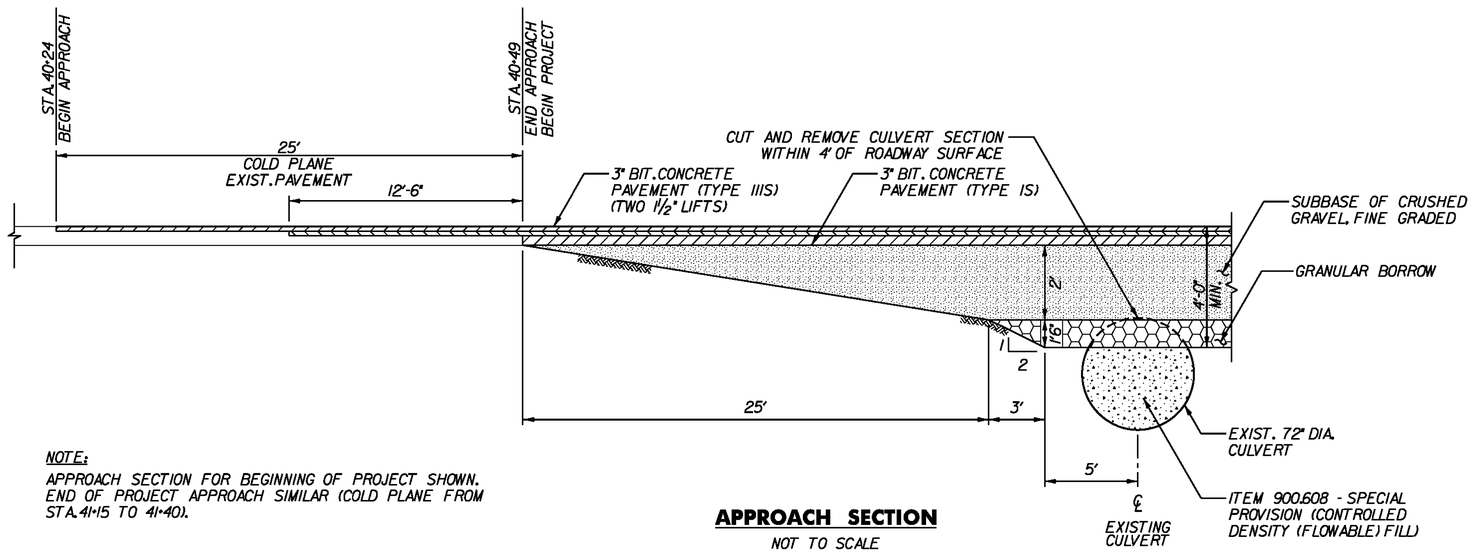

NOTE:
APPROACH SECTION FOR BEGINNING OF PROJECT SHOWN. END OF PROJECT APPROACH SIMILAR (COLD PLANE FROM STA.41+15 TO 41+40).

APPROACH SECTION

NOT TO SCALE

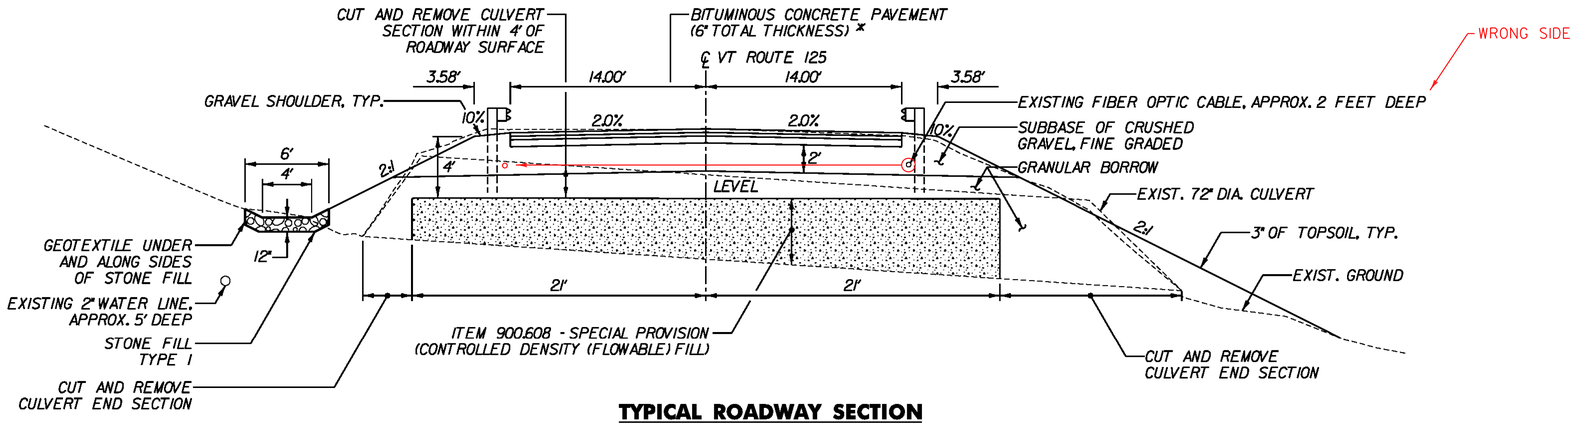

TYPICAL ROADWAY SECTION

NOT TO SCALE

* BITUMINOUS CONCRETE PAVEMENT:
1½" TYPE IIIS OVER
1½" TYPE IIIS OVER
3" TYPE IS

SUBBASE:
SUBBASE OF CRUSHED GRAVEL, FINE GRADED

MATERIAL ITEM	TOLERANCE
PAVEMENT	+/- ¼" TOTAL THICKNESS
SUBBASE	+/- 1"

Stantec

PROJECT NAME:	BRIDPORT
PROJECT NUMBER:	STP CULV(21)
FILE NAME: ...\03-typical sections.dgn	PLOT DATE: 10/8/2010
PROJECT LEADER: G. BOGUE	DRAWN BY: E. ALLING
DESIGNED BY: M. CHENETTE	CHECKED BY: G. BOGUE
TYPICAL SECTIONS	SHEET 3 OF 14