617.10 RELOCATE MAILBOX, SINGLE SUPPORT
WESTFORD
STA. 344+76, LT
STA. 344+80, LT
STA. 344+82, LT
STA. 345+65, LT
FAIRFAX
STA. 0+38, RT
STA. 2+07, LT
STA. 3+11, LT

646.402 DURABLE 4 INCH WHITE LINE, THERMOPLASTIC
(ALL LINES WILL INCLUDE EDGE LINE BREAKS AND RADII FOR SIDE ROADS)
WESTFORD
STA. 344+50 TO 346+72 SOLID LT & RT
FAIRFAX
STA. 0+00 TO 3+50, SOLID LT & RT

646.412 DURABLE 4 INCH YELLOW LINE, THERMOPLASTIC
(ALL LINES WILL INCLUDE ℄ BREAKS FOR SIDE ROADS)
WESTFORD
STA. 344+50 TO 346+72 DASHED LT, SOLID RT
FAIRFAX
STA. 0+00 TO 3+50, DASHED LT, SOLID RT

646.602 TEMPORARY 4 INCH WHITE LINE, PAINT
(ALL LINES WILL INCLUDE EDGE LINE BREAKS AND RADII FOR SIDE ROADS)
WESTFORD
STA. 344+50 TO 346+72 SOLID LT & RT
FAIRFAX
STA. 0+00 TO 3+50, SOLID LT & RT

646.612 TEMPORARY 4 INCH YELLOW LINE, PAINT
(ALL LINES WILL INCLUDE ℄ BREAKS FOR SIDE ROADS)
WESTFORD
STA. 344+50 TO 346+72 DASHED LT, SOLID RT
FAIRFAX
STA. 0+00 TO 3+50, DASHED LT, SOLID RT

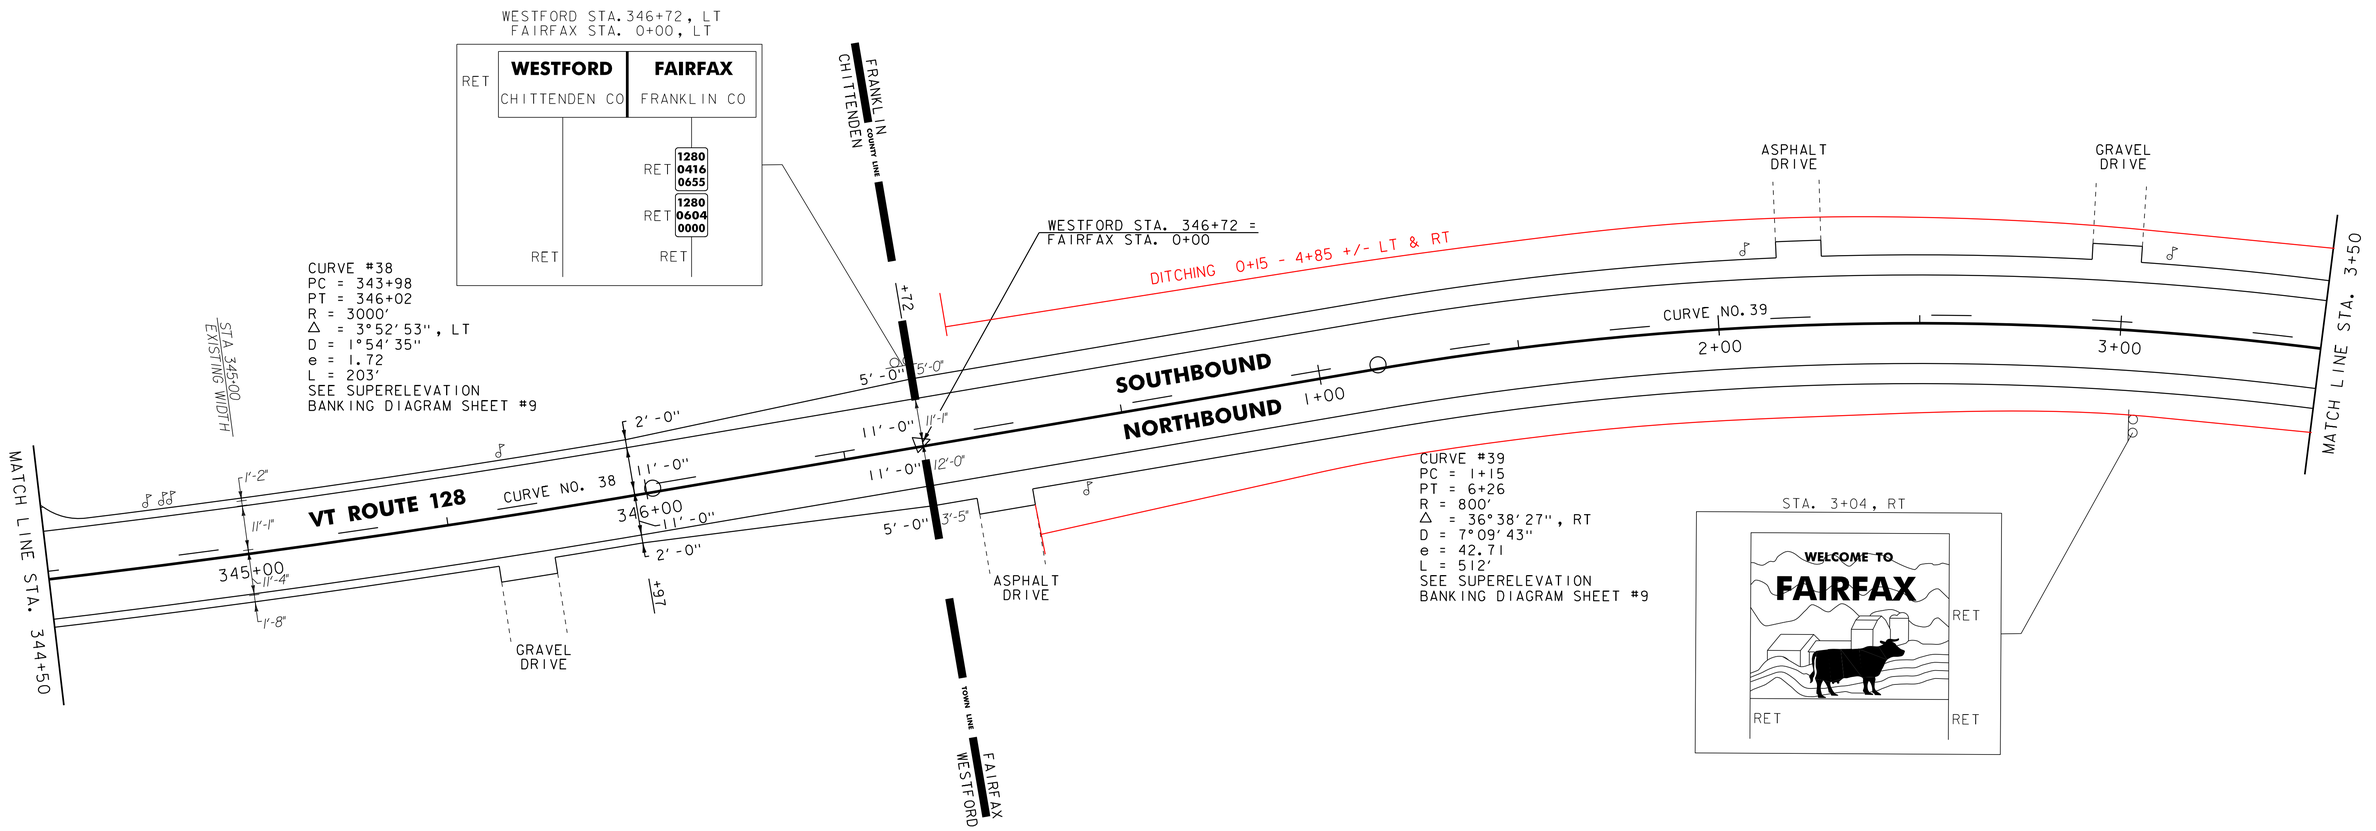

NOTES:
1. ALL EXISTING SIGNS NOT SHOWN SHALL BE RETAINED.
2. FOR LEGENDS, SEE LAYOUT SHEET #1.

NOT TO SCALE

Stantec

PROJECT LAYOUT SHEET #29

PROJECT NAME: WESTFORD - FAIRFAX
PROJECT NUMBER: STP 2804(I)

FILE NAME: p08c212.dgn
PROJECT LEADER: JLL
DESIGNED BY: STANTEC
IPARM FILE: p08c212I29.i
PLOT DATE: 31-OCT-2012 13:58
DRAWN BY: STANTEC
CHECKED BY: JLL
SHEET 45 OF 79