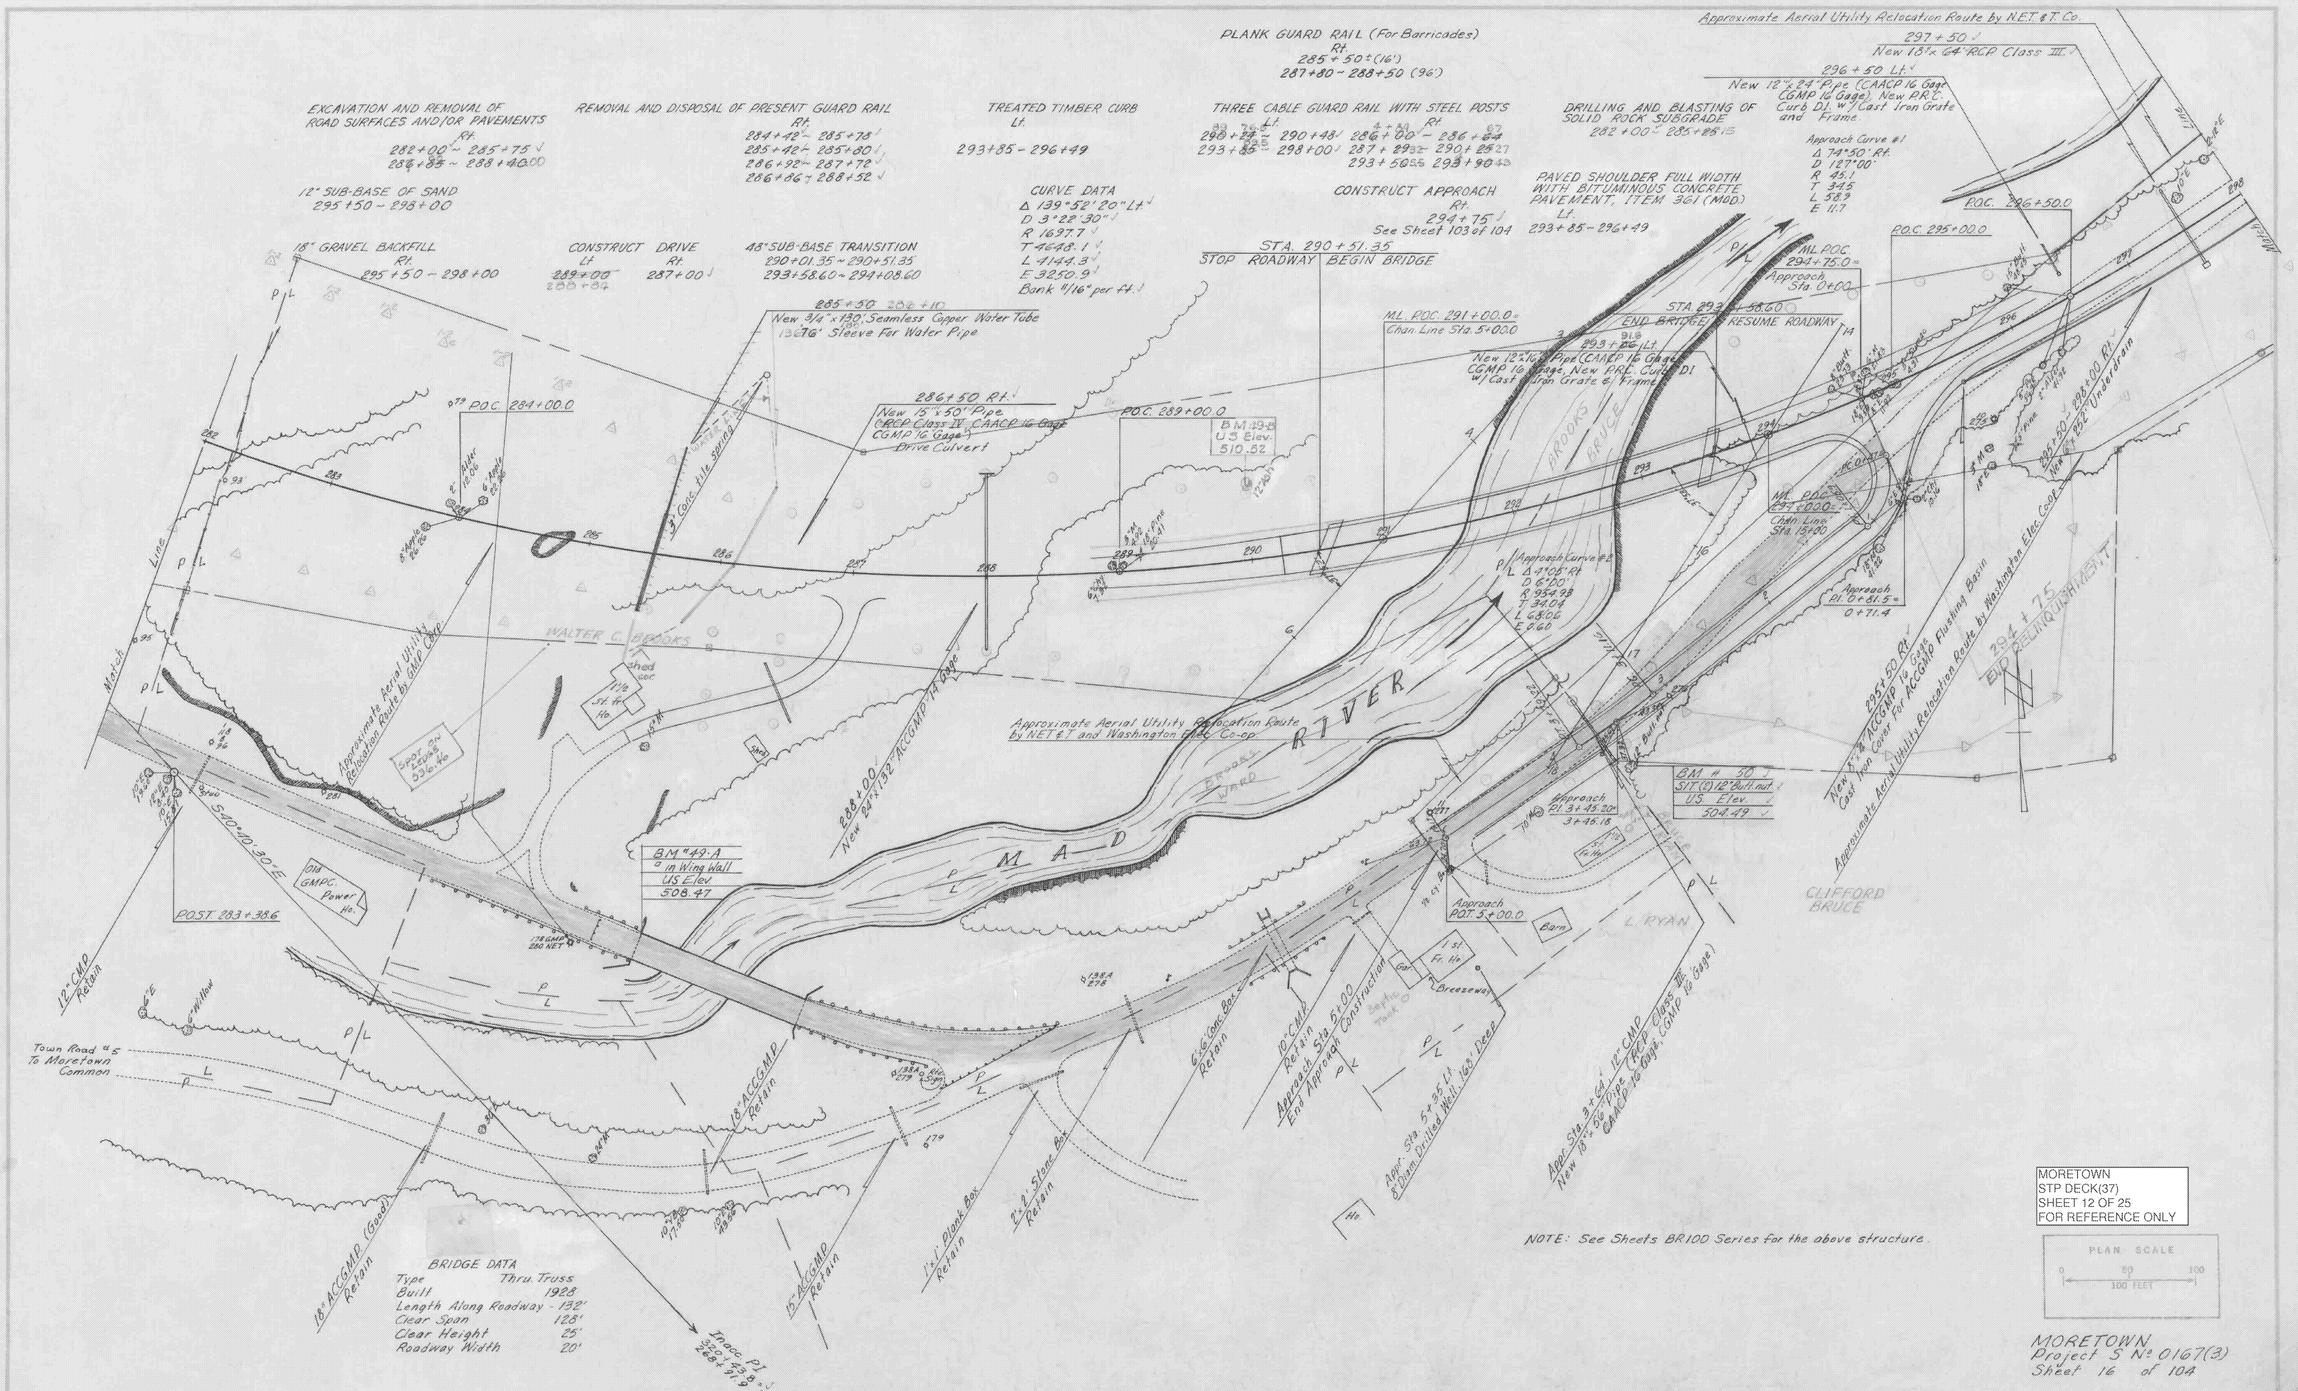

PLAN			
SURVEYED		BY	DATE
PLOTTED			
ALIGNMENT CHECKED		A. Gagnon	May 63
BS OF MAP			
NOTE BOOK			
NO.		A. Gagnon	Aug 63

BRIDGE DATA

Type	Thru Truss
Built	1928
Length Along Roadway	132'
Clear Span	128'
Clear Height	25'
Roadway Width	20'

NOTE: See Sheets BR100 Series for the above structure.

MORETOWN
STP DECK(37)
SHEET 12 OF 25
FOR REFERENCE ONLY

PLAN SCALE
0 50 100
100 FEET

MORETOWN
Project S No 0167(3)
Sheet 16 of 104