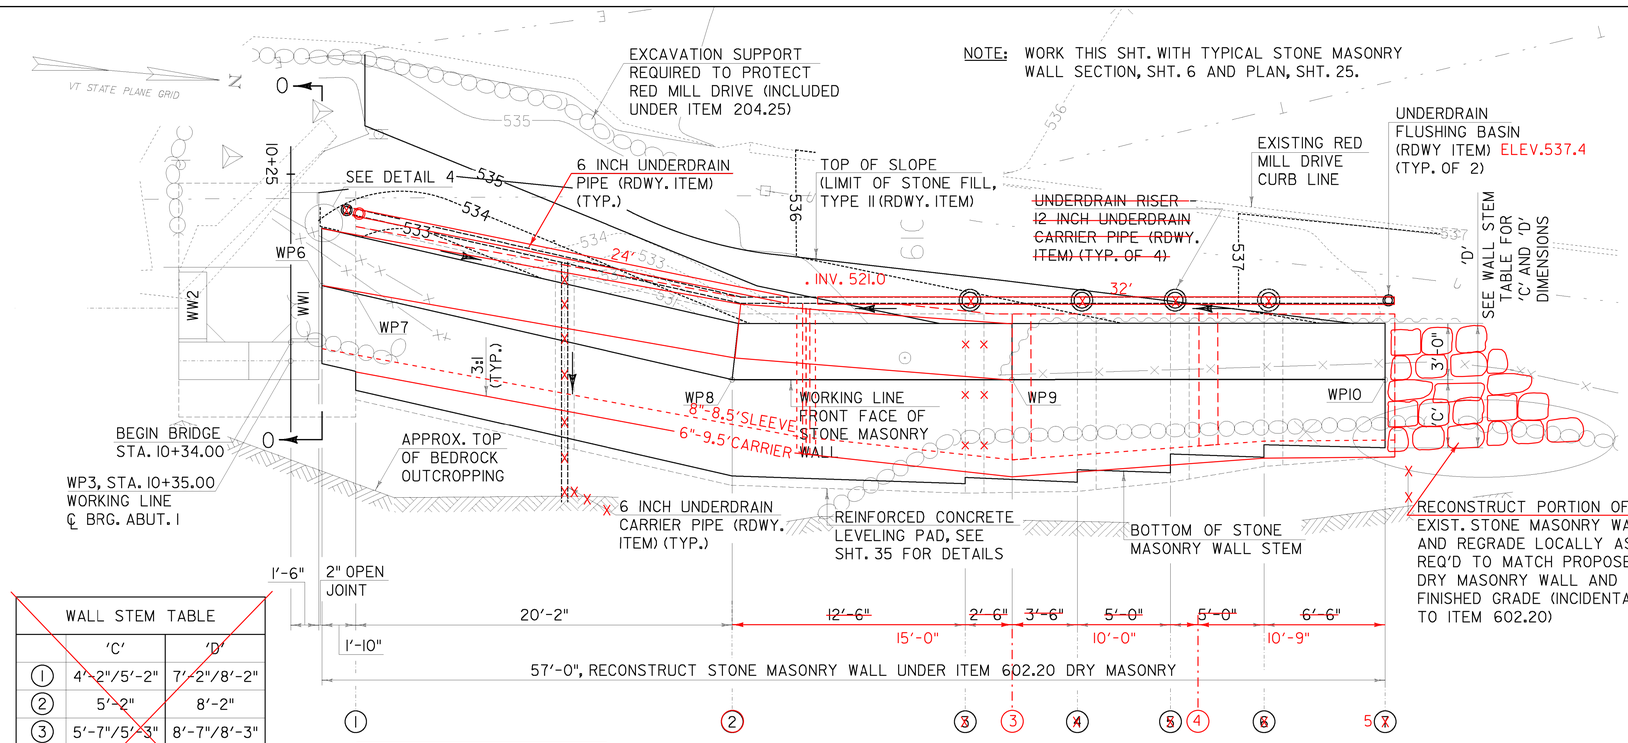

WALL STEM TABLE		
	'C'	'D'
1	4'-2"/5'-2"	7'-2"/8'-2"
2	5'-2"	8'-2"
3	5'-7"/5'-3"	8'-7"/8'-3"
4	5'-6"/4'-10"	8'-6"/7'-10"
5	5'-0"/4'-0"	8'-0"/7'-0"
6	4'-2"/3'-6"	7'-2"/6'-6"
7	3'-8"	6'-8"

SEE NEW TABLE

WALL STEM TABLE		
	'C'	'D'
1	2.85'/3.85'	5.85'/6.85'
2	3.85'	6.85'
3	4.36'/3.35'	7.35'/6.35
4	3.65'/3.02'	6.68'/6.02'
5	3.35'	6.35'

STONE MASONRY WALL PLAN

SCALE: 1/4" = 1'-0"

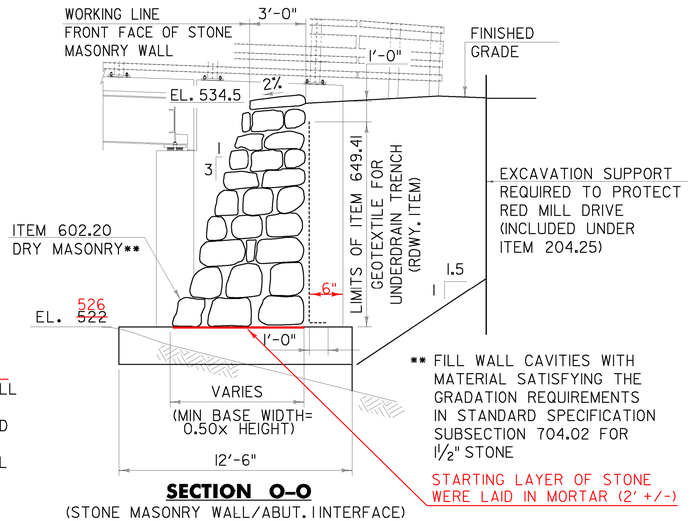

SECTION O-O

(STONE MASONRY WALL/ABUT. 1 INTERFACE)
SCALE: 1/4" = 1'-0"

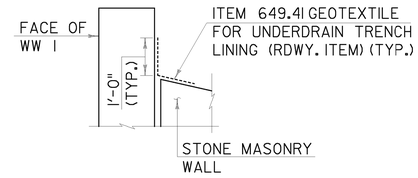

DETAIL 4

SCALE: 1/4" = 1'-0"

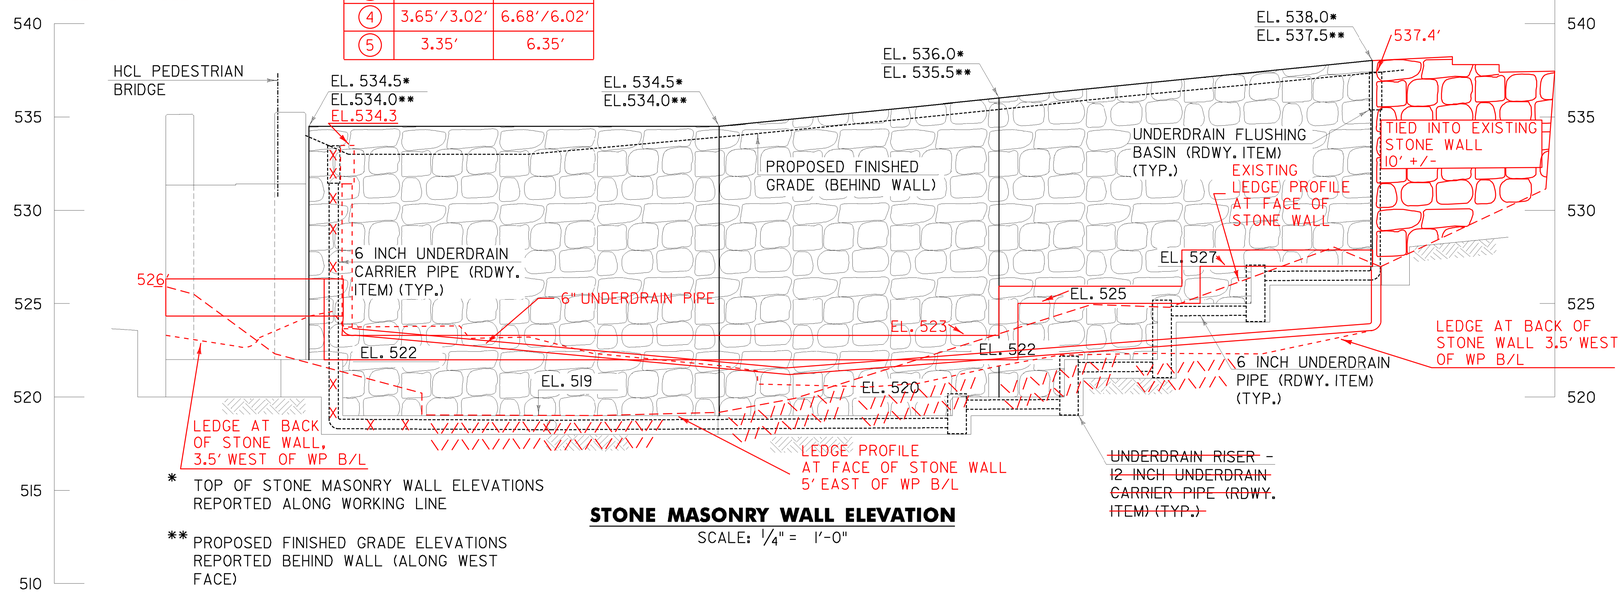

* TOP OF STONE MASONRY WALL ELEVATIONS REPORTED ALONG WORKING LINE

** PROPOSED FINISHED GRADE ELEVATIONS REPORTED BEHIND WALL (ALONG WEST FACE)

STONE MASONRY WALL ELEVATION

SCALE: 1/4" = 1'-0"

NOTES:

1. STONE MASONRY WALL LEVELING PAD ELEVATIONS ARE BASED ON APPROXIMATION OF THE EXISTING BEDROCK PROFILE. THE DESIGN HEIGHT OF THE STONE MASONRY WALL SEGMENTS WERE DETERMINED BASED ON THE ELEVATIONS SHOWN. THE INTENT IS FOR THE CONTRACTOR TO PROVIDE THE PROPOSED FINISHED GRADE (BEHIND WALL) AS SHOWN IN THE STONE MASONRY WALL PLAN AND ELEVATION.

2. FOR BIDDING PURPOSES, QUANTITIES OF 36 LF AND 14 LF HAVE BEEN INCLUDED UNDER ITEMS 605.20, 6 INCH UNDERDRAIN CARRIER PIPE AND ITEM 605.23, 12 INCH UNDERDRAIN CARRIER PIPE, RESPECTIVELY. IT SHOULD BE NOTED THAT TO SUIT ACTUAL FIELD CONDITIONS, THESE QUANTITIES MAY REQUIRE ADJUSTMENT.

3. FOR ADDITIONAL UNDERDRAIN DETAILS, SEE SHTS. 5 AND 16.

SCALE 1/4" = 1'-0"
1 0 2 4 6

STONE MASONRY WALL PLAN AND DETAILS

PROJECT NAME: JERICHO
PROJECT NUMBER: STP FTBR (3)

PROJECT LEADER: M.D.S.
DESIGNED BY: D.M.D.
PLOT DATE: 4/8/2014
DRAWN BY: D.M.D.
CHECKED BY: P.M.P.
SHEET 33 OF 62

FILE NAME = V:\Projects\VNY\K2\21113\CADD\MSTN\08F004\Consultants\x08f004detail3.dgn
DATE/TIME = 4/8/2014
USER = ADM