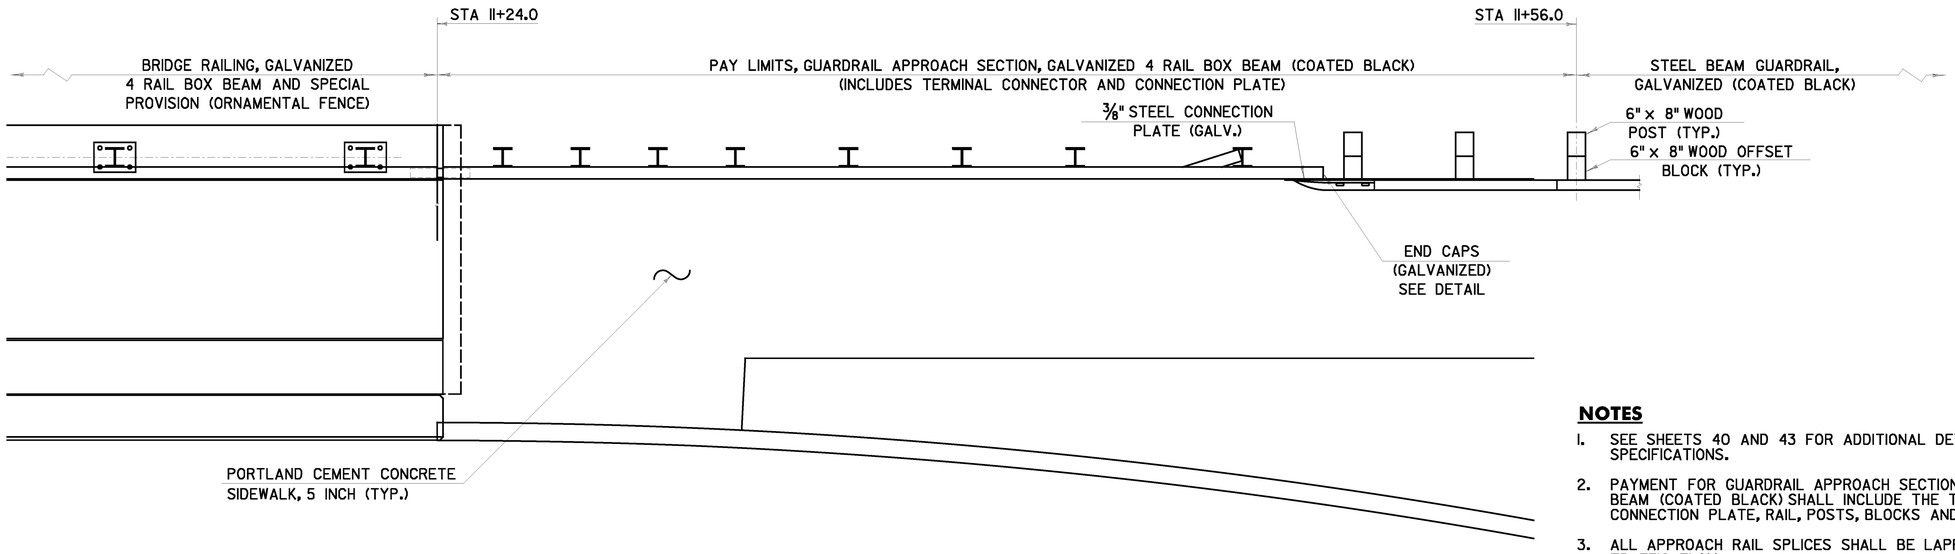

PLAN VIEW – GUARDRAIL APPROACH SECTION, GALVANIZED 4 RAIL BOX BEAM (COATED BLACK)

STA 11+24.0 – STA 11+56.0

NOTES

1. SEE SHEETS 40 AND 43 FOR ADDITIONAL DETAILS, NOTES, AND SPECIFICATIONS.
2. PAYMENT FOR GUARDRAIL APPROACH SECTION, GALVANIZED 4 RAIL BOX BEAM (COATED BLACK) SHALL INCLUDE THE TERMINAL CONNECTOR, THE CONNECTION PLATE, RAIL, POSTS, BLOCKS AND ATTACHMENT HARDWARE.
3. ALL APPROACH RAIL SPLICES SHALL BE LAPPED IN THE DIRECTION OF TRAFFIC FLOW.
4. ALL BRIDGE APPROACH RAIL MATERIALS, DIMENSION SIZES AND NOTES SHALL BE THE SAME AS THOSE OF THE BRIDGE RAIL, UNLESS OTHERWISE NOTED.
5. CARRIAGE BOLTS SHALL BE AASHTO M164 AND NUTS SHALL BE ASTM A563 GRADE A OR BETTER (GALVANIZED).
6. WELD SPLICE BARS TO FIT BEND. USE COMPLETE PENETRATION WELD (B-U2).
7. SEE SHEET 43 FOR SECTION B-B.

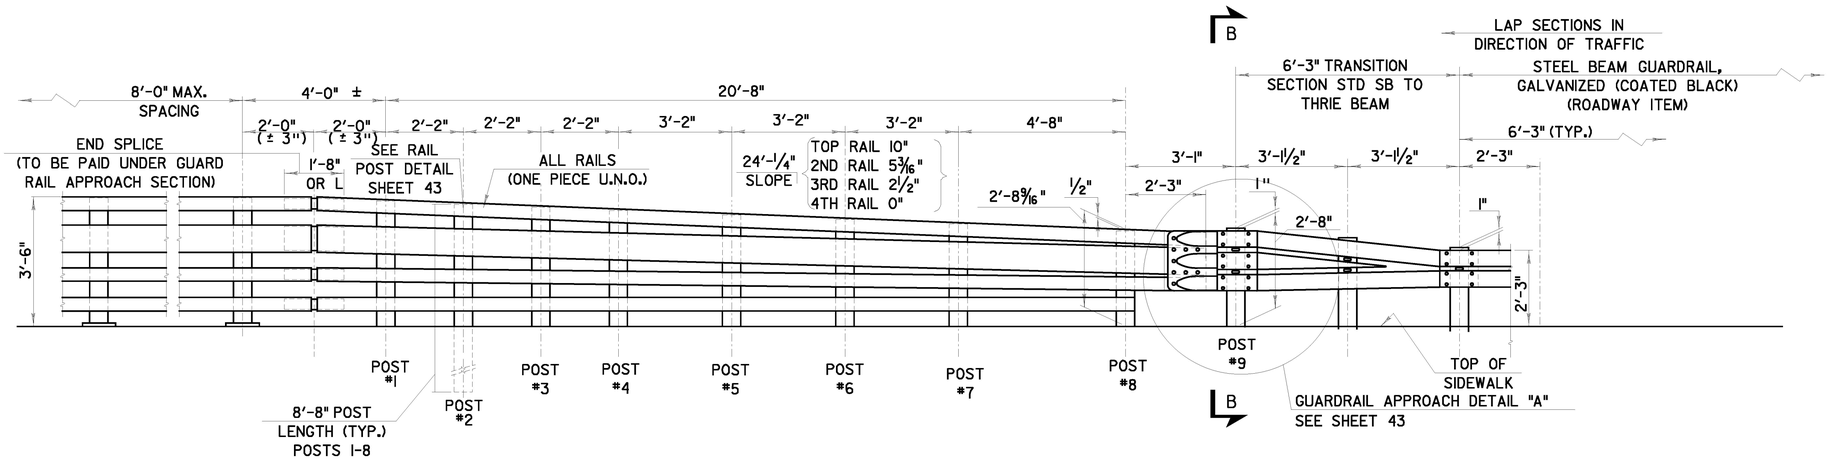

TYPICAL ELEVATION –
GUARDRAIL APPROACH SECTION, GALVANIZED 4 RAIL BOX BEAM (COATED BLACK)

SCALE 1/2" = 1'-0"

CHA

GUARDRAIL APPROACH SECTION DETAILS #2

PROJECT NAME: JERICHO
PROJECT NUMBER: STP FTBR (3)

PROJECT LEADER: M.D.S.
DESIGNED BY: C.R.H.
DWG. NO.: GRAPP-2

PLOT DATE: 4/7/2014
DRAWN BY: C.R.H.
CHECKED BY: D.E.G.
SHEET 42 OF 62

FILE NAME = V:\Projects\VNYK2\21113\CADD\MSTN\08F004\Consultants\08f004approrail2.dgn
DATE/TIME = 4/7/2014
USER = KHL