GRAVEL SURFACE COURSE REQUIRED
ESTIMATED QUANTITY = 218 CUYDS.

CABLE GUARD RAIL REQUIRED
STA. 5+27 TO STA. 5+51 24 LIN. FT.
on left.

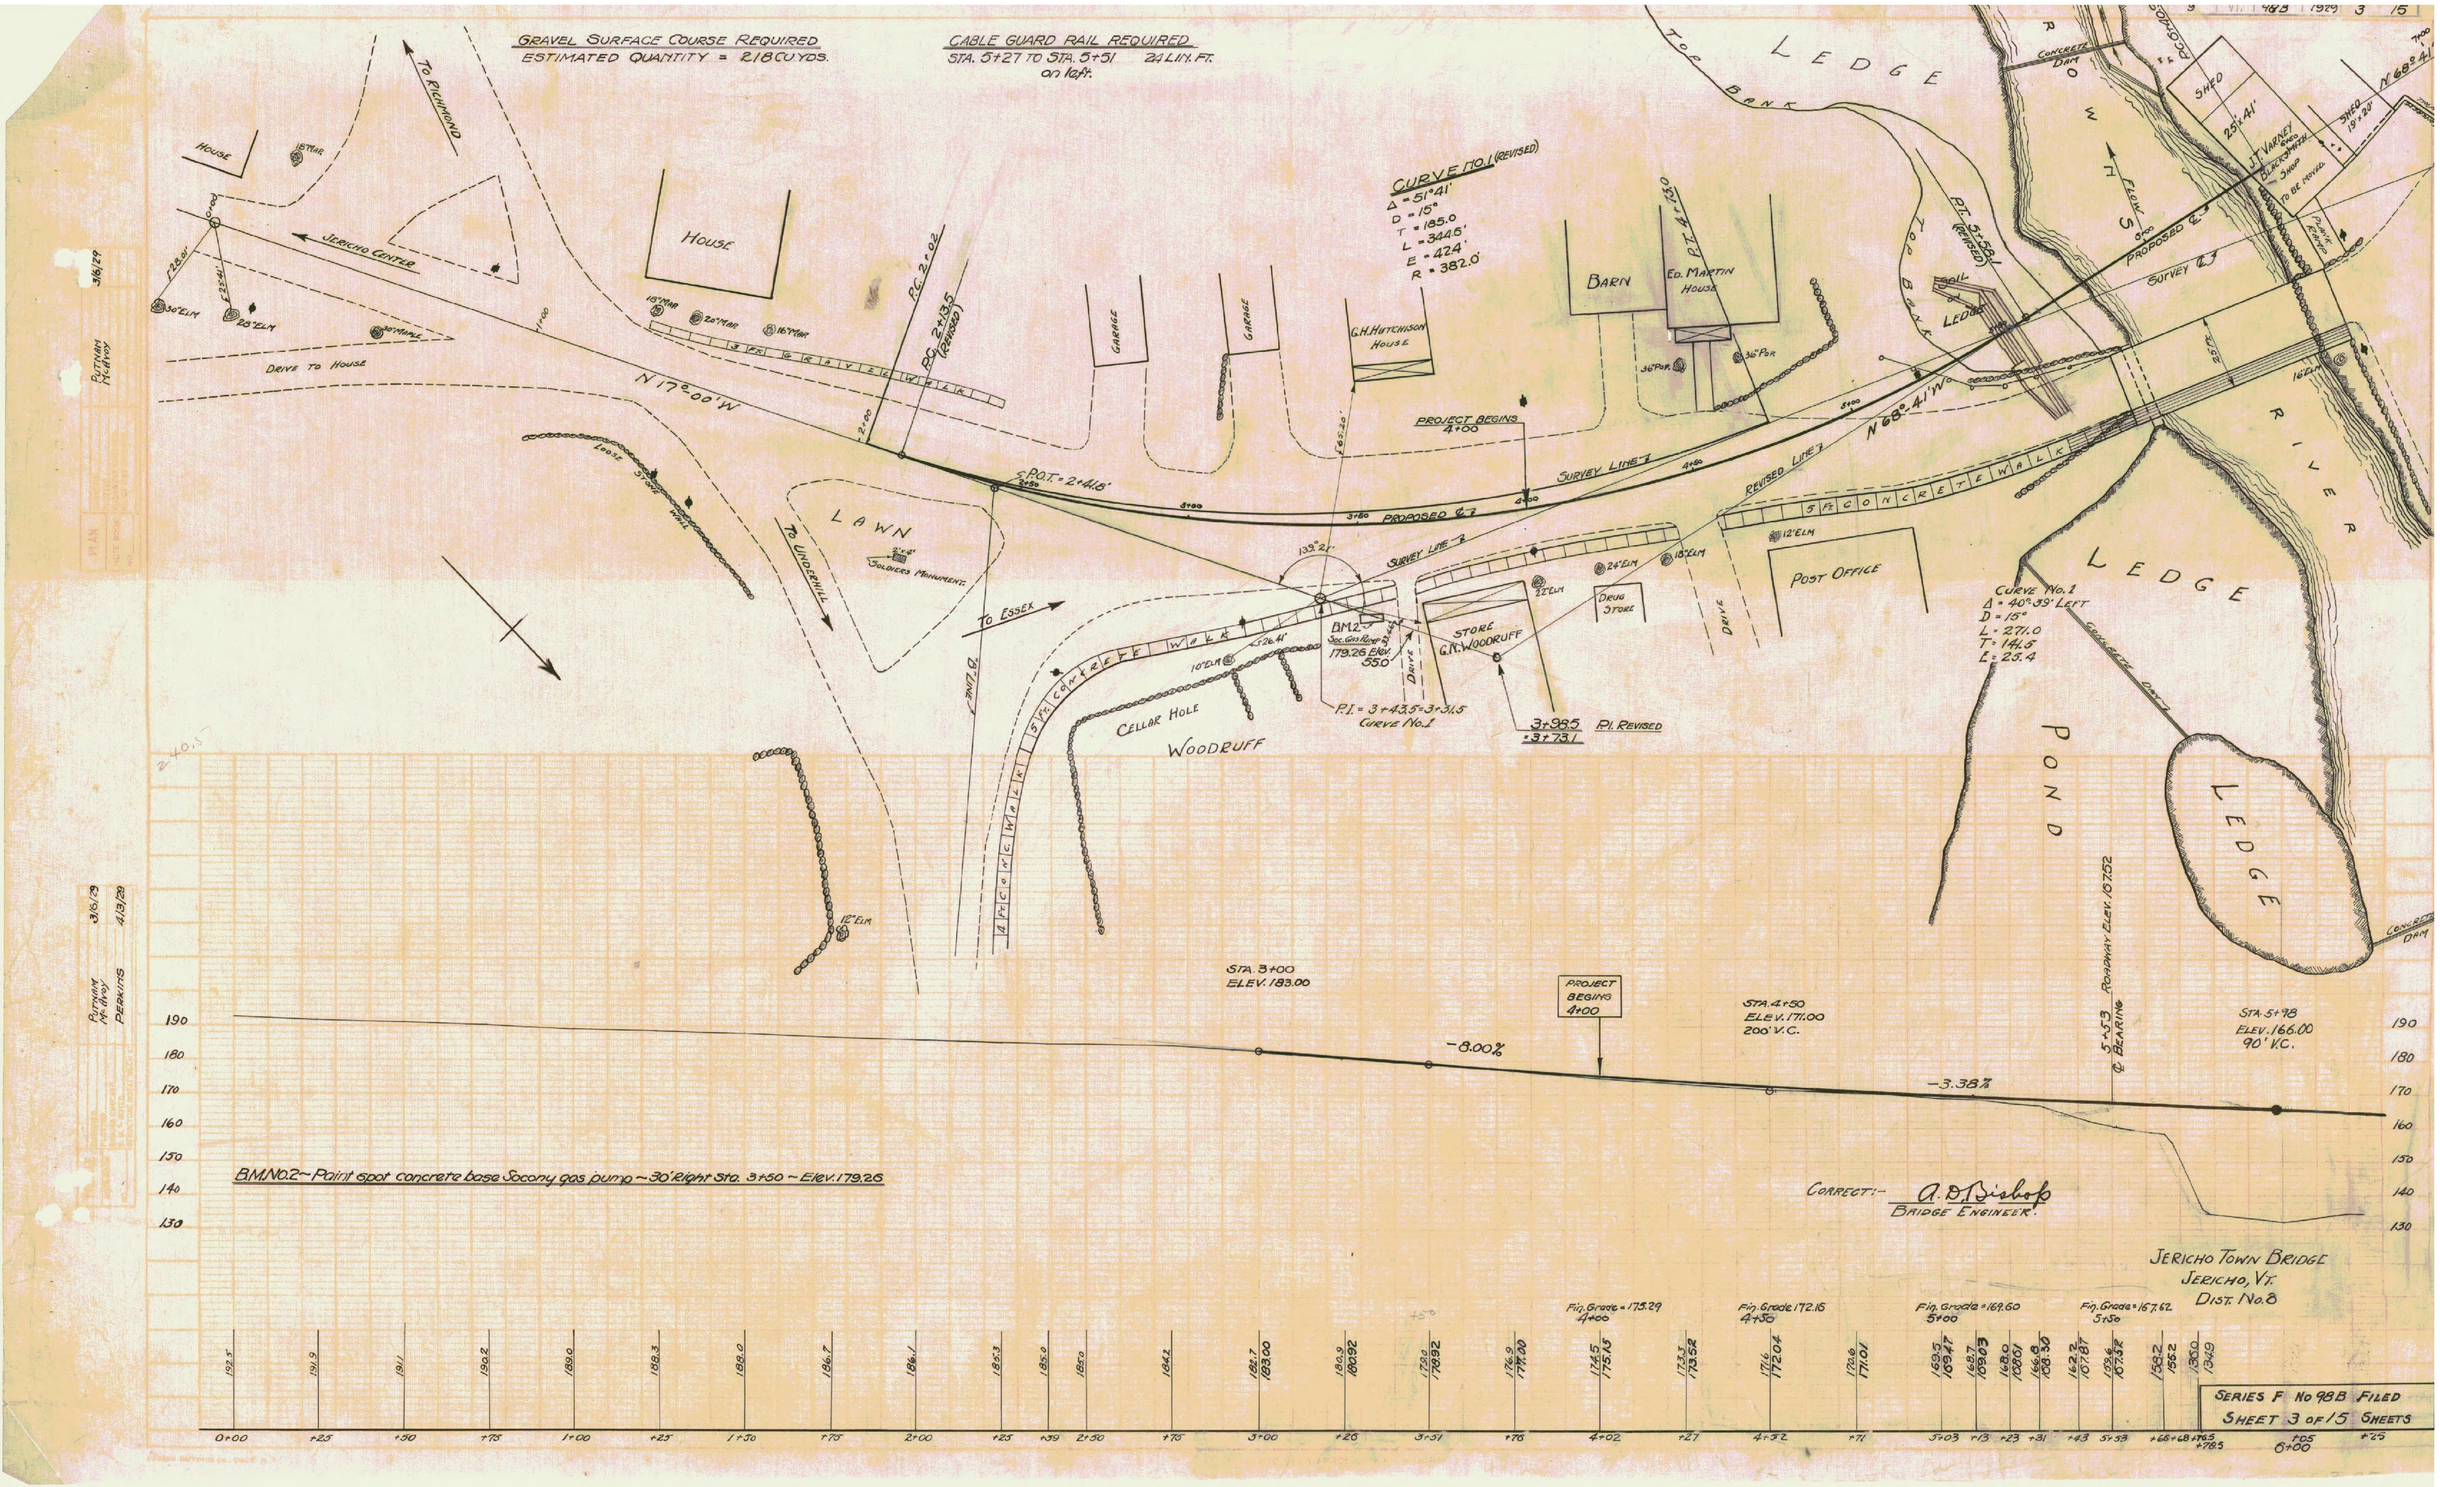

CORRECT:- A. D. Bishop
BRIDGE ENGINEER.

JERICHO TOWN BRIDGE
JERICHO, VT.
DIST. No. 8

SERIES F No. 988 FILED
SHEET 3 OF 15 SHEETS

PLAN
NOTE BOOK
No.
PUTNAM Hy. Engr. 3/6/29
PUTNAM Hy. Engr. 3/6/29
PUTNAM Hy. Engr. 4/13/29
PUTNAM Hy. Engr. PERKINS