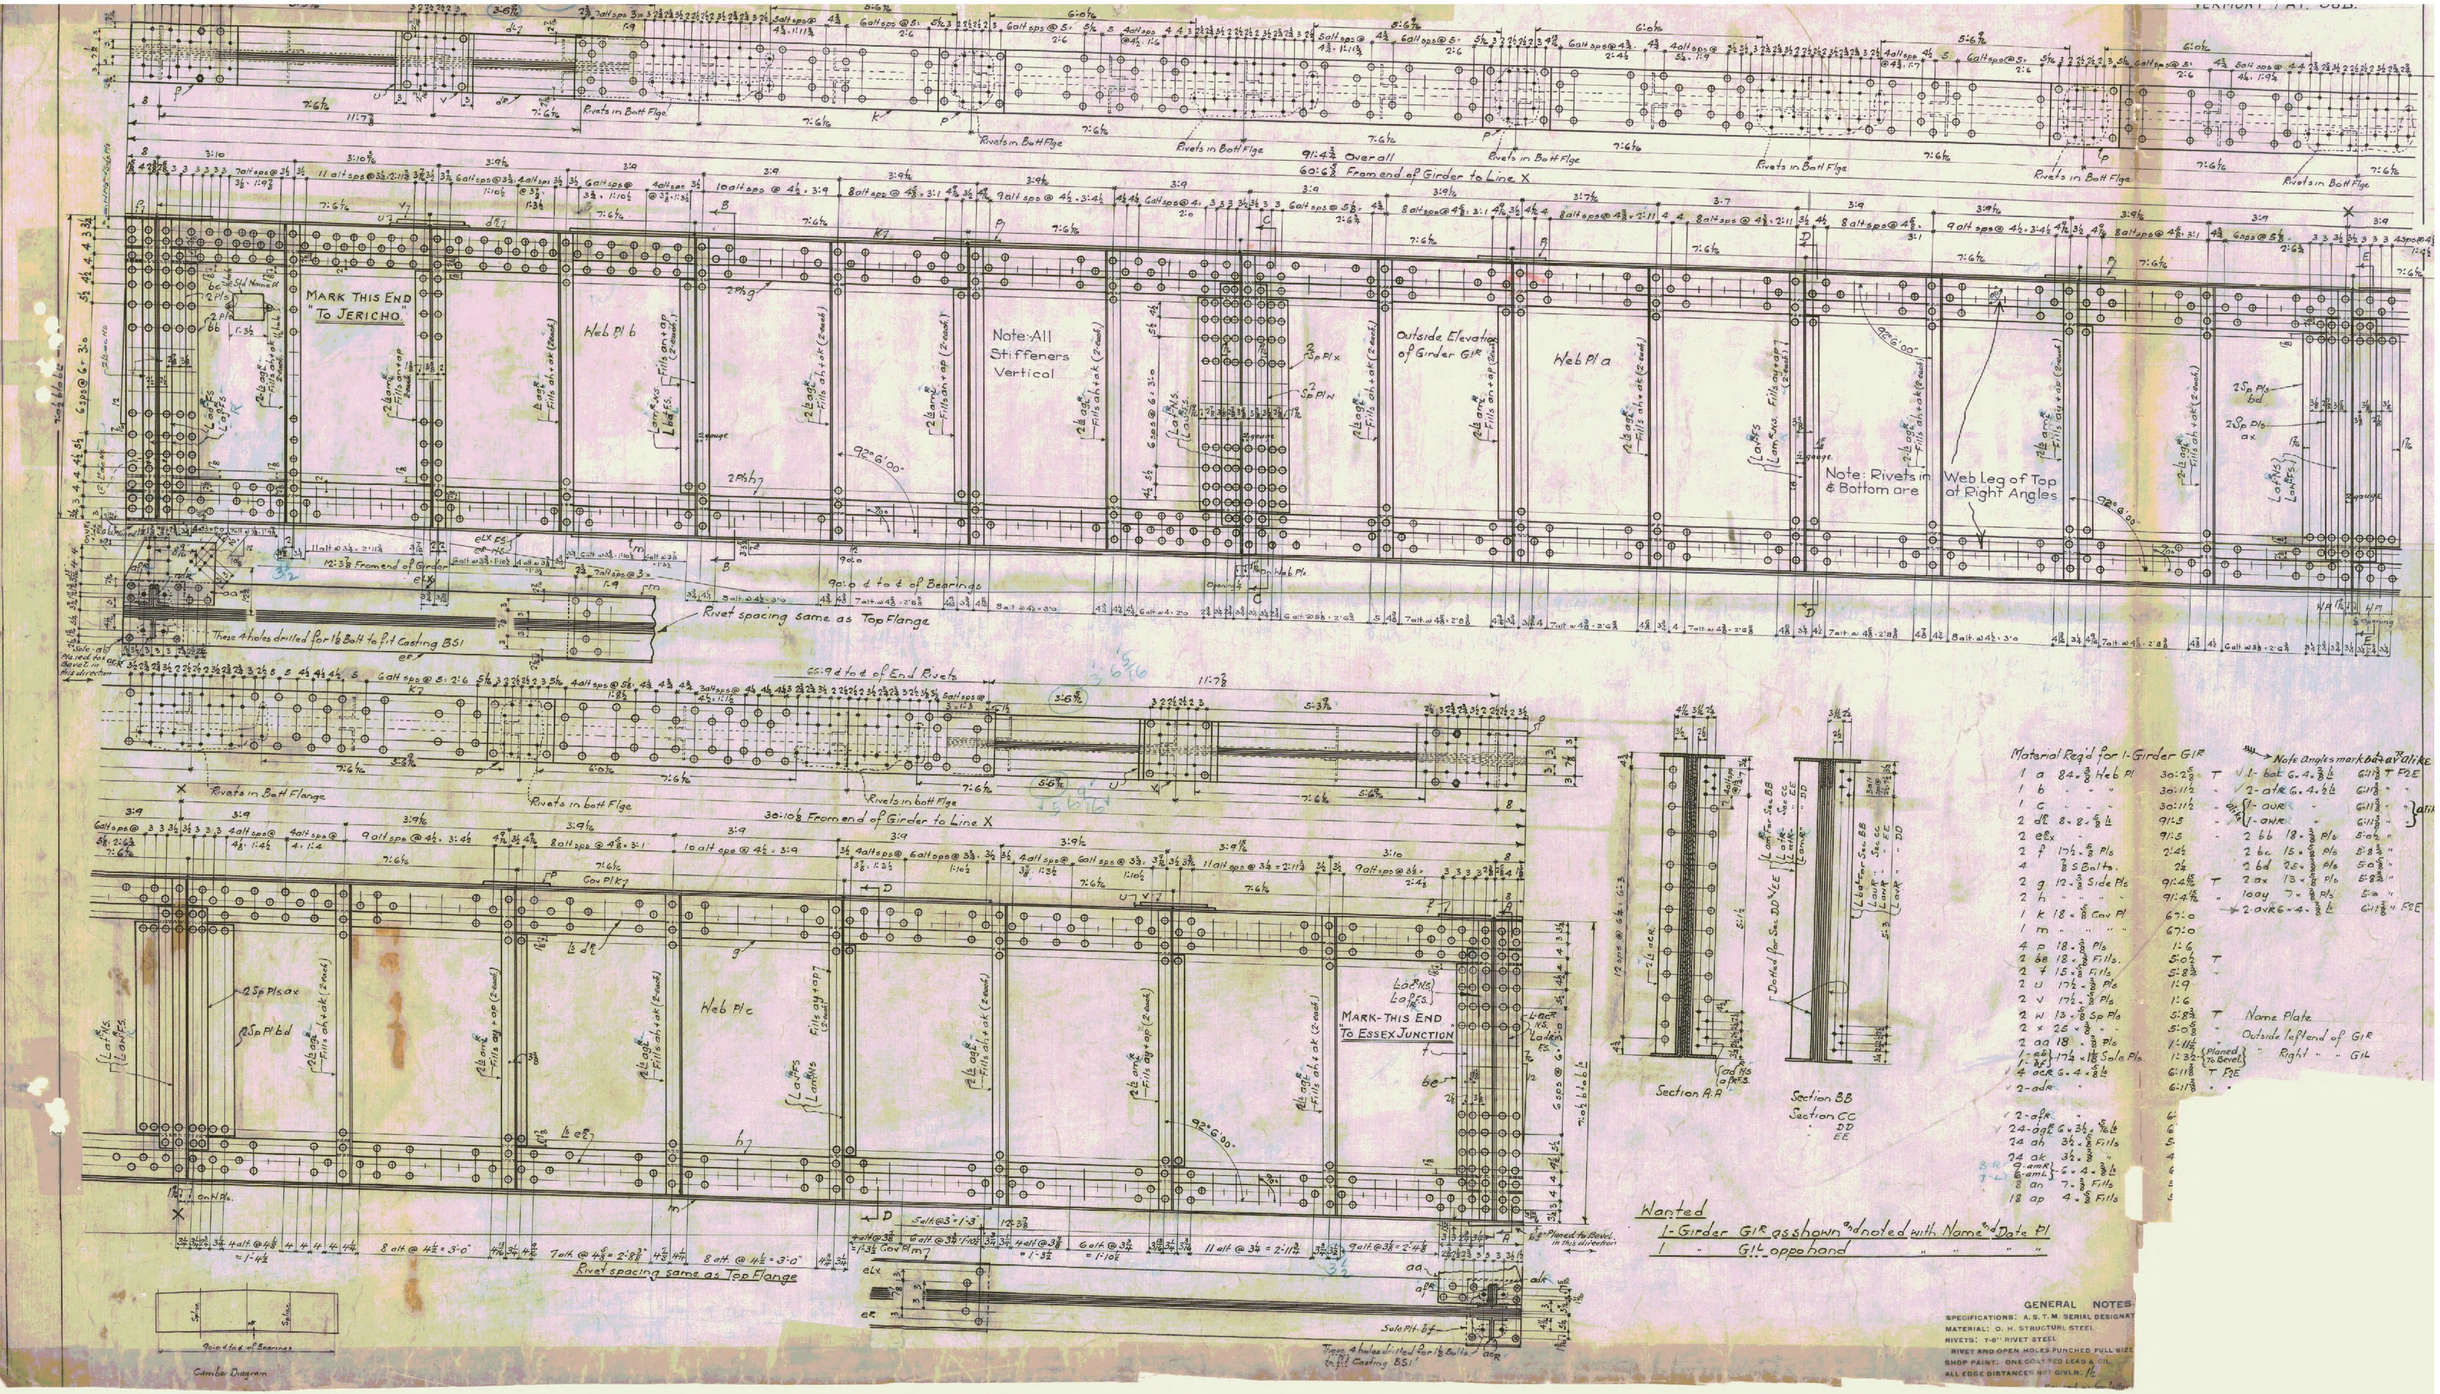
91:4¾ Overall
60:6¾ From end of Girder to Line X
30:10⅛ From end of Girder to Line X
Rivets in Batt Flge
MARK THIS END "TO JERICHO"
MARK THIS END "TO ESSEX JUNCTION"
Web Pl b
Web Pl a
Web Pl c
Note: All Stiffeners Vertical
Outside Elevation of Girder G1R
Note: Rivets in Web Leg of Top & Bottom are at Right Angles
92°6'00"
90:0 d to c of Bearings
Rivet spacing same as Top Flange
These 4 holes drilled for 1⅛ Bolt to fit Casting B51
Section A-A
Section BB
Section CC
DD
EE
Camber Diagram
Material Req'd for 1-Girder G1R
Note Angles mark bot & top alike
Wanted
1-Girder G1R as shown and noted with Name and Date Pl
1 - G1L opposite hand
GENERAL NOTES
SPECIFICATIONS: A. S. T. M. SERIAL DESIGNAT
MATERIAL: O. H. STRUCTURAL STEEL
RIVETS: 7-8" RIVET STEEL
RIVET AND OPEN HOLES PUNCHED FULL SIZE
SHOP PAINT: ONE COAT RED LEAD & OIL
ALL EDGE DISTANCES NOT GIVEN: ½