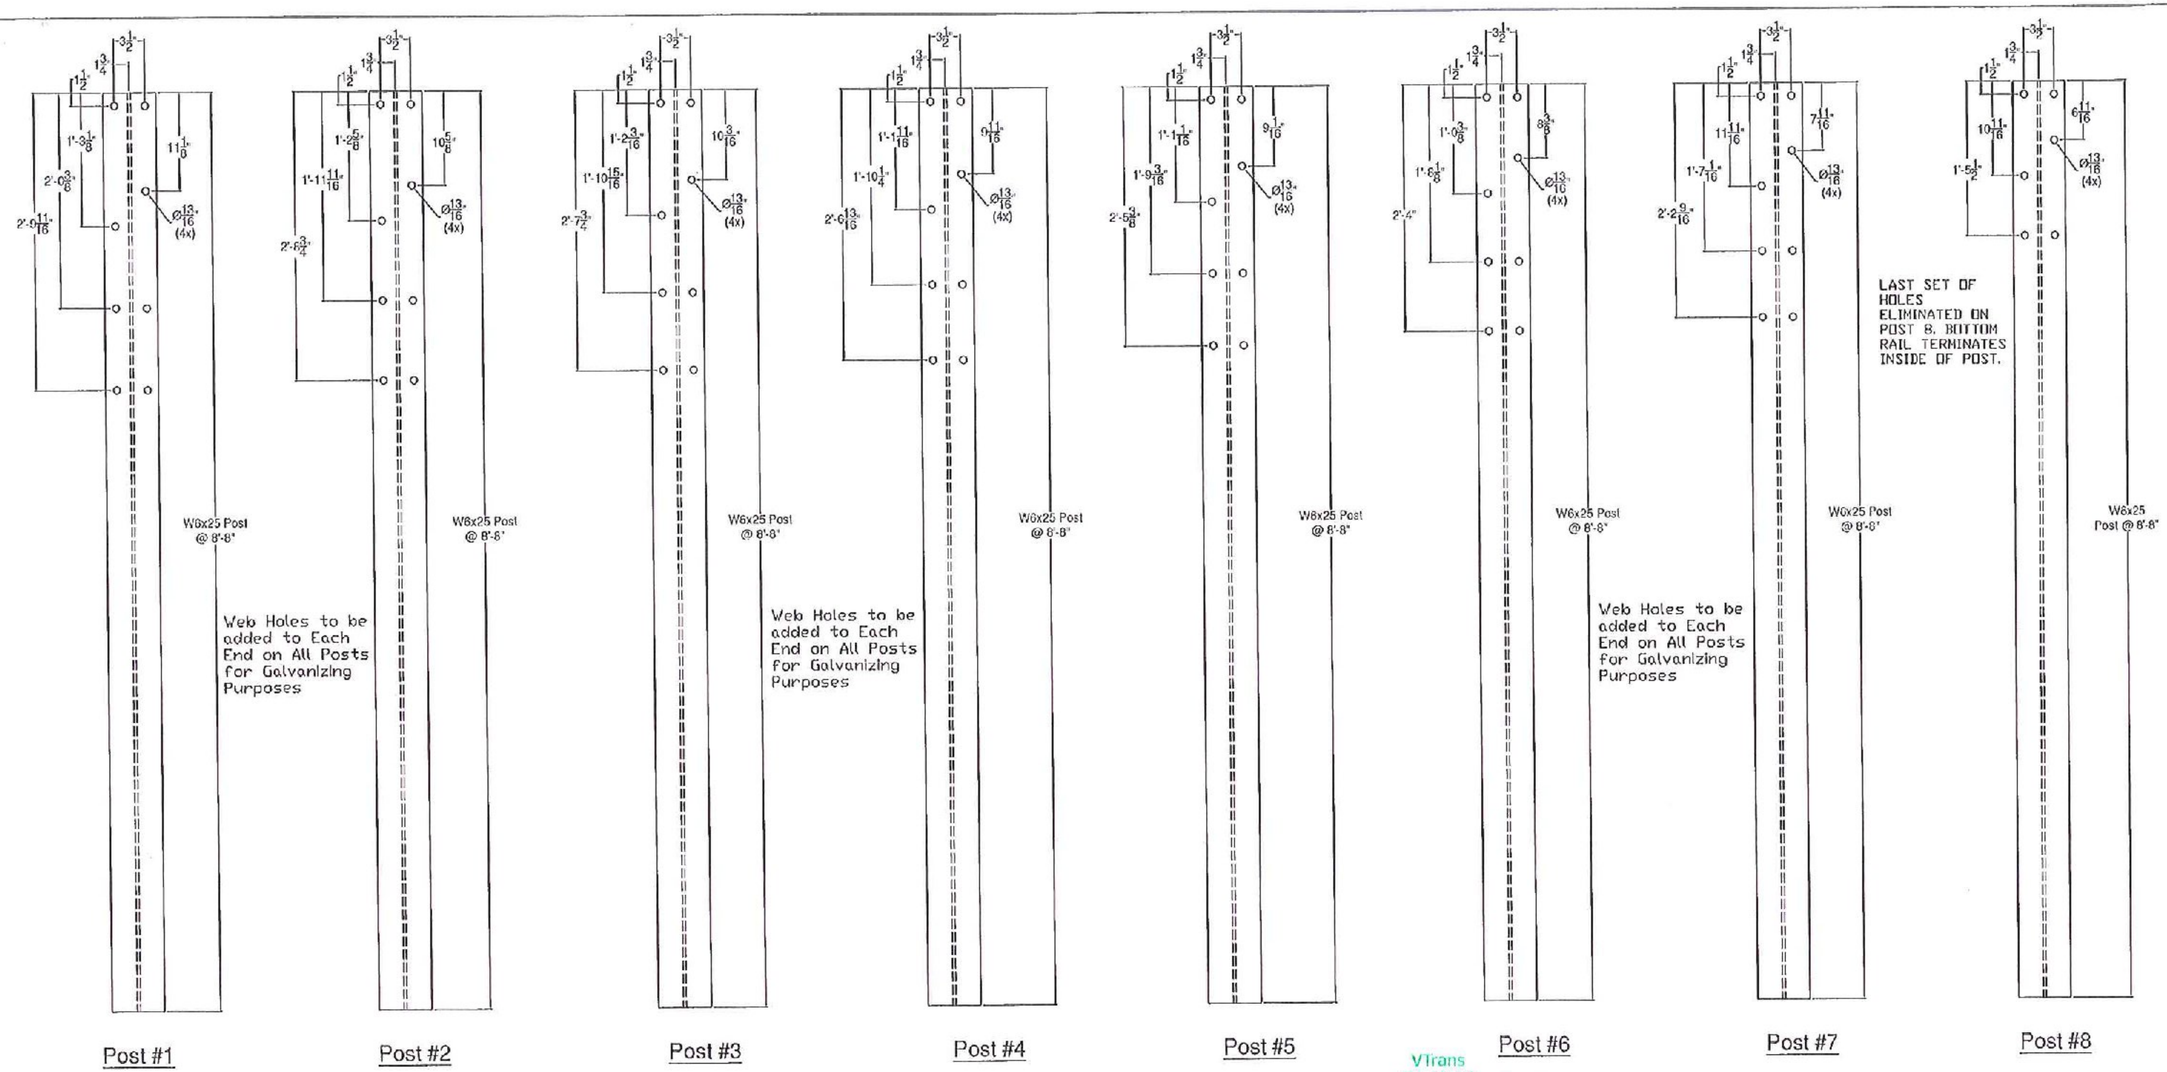

VTrans Received
CK'D_____ OK'd BY JWC

AUG 06 2014

POWDER COATED BLACK AFTER GALV. PER ASTM D7803

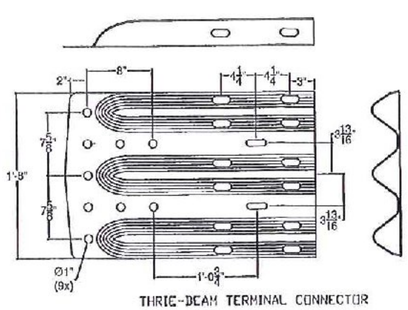

THRIE-BEAM TERMINAL CONNECTOR

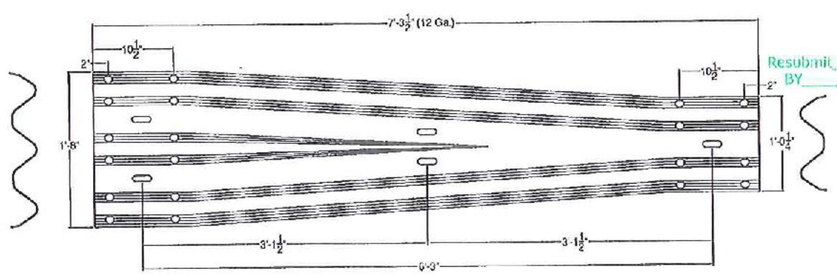

THRIE-BEAM TO STD. SB TRANSITION SECTION

Resubmit_____ APPROVED ✓
BY_____ DATE 8/12/14

ITEM #: 621.73 GEN CONTR: F.R. LAFAYETTE, P.O. 29045

SHEET 3 OF 3

APPROVED BY:

BRIDGE RAIL DETAILS SHEET

PROJECT: TOWN OF JERICHO COUNTY OF CHITTENDEN VT. 15 (MINOR ARTERIAL) PEDESTRIAN BRIDGE
JERICHO FTBR (3)

REV	NO.	DATE	DESCRIPTION	BY	REV	NO.	DATE	DESCRIPTION	BY

ELDERLEE, INC.
OAKS CORNERS, NEW YORK 14518
E-Mail: dlong@elderlee.com
Tel: 315-789-6670 Fax: 315-789-6615

AISC CERTIFIED FABRICATOR

DRAWN	D.L.	7/23/2014
CHECKED	E.P.	7/23/2014
APPROVED		
SCALE	SCHEMATIC	
DRAWING NO.	F.R.L. JERICHO 29045 GPAS	