DIR	MILEPOINT	LOCATION CODE (SHEET 2)	MUTCD CODE	WIDTH (IN)	HEIGHT (IN)	SHEETING REMARKS	SIGN LEGEND FOR POST LENGTHS AND INSTALLATION DATES SEE ORIGINAL RECORD PLANS	NEW SIGNS "A"	NEW SIGNS "B"	EXISTING SIGNS RETAIN	EXISTING SIGNS SALVAGE FROM	EXISTING SIGNS SALVAGE TO	EXISTING SIGNS REMOVE	EXIST POST RETAIN	EXIST POST REMOVE	NUMBER OF NEW POSTS	SQUARE STEEL (in) 2.00 (LB / FT) 2.16	SQUARE STEEL (in) 2.00 (LB / FT) 2.42	SQUARE STEEL (in) 2.50 (LB / FT) 3.35	TUBULAR STEEL Ø (IN) FOUNDATION	TUBULAR STEEL Ø (IN) 3.00 (LB / FT) 7.60	TUBULAR STEEL Ø (IN) 3.50 (LB / FT) 9.00	TUBULAR STEEL Ø (IN) 4.00 (LB / FT) 10.80	TUBULAR STEEL Ø (IN) 5.00 (LB / FT) 14.60	SIGN FRAME REQUIRED	REMARKS	SIGN DETAIL: DETAIL IN SHS	SIGN DETAIL: DETAIL ON SHEET NUMBER	SIGN DETAIL: DETAIL ON STD SHEET NUMBER
WINHALL VT11							"FY"-FLUORESCENT YELLOW "FYG"-FLUORESCENT YELLOW GREEN																			"SHS"-STANDARD HIGHWAY SIGNS			
EB	0.000	C	VD-024	60	7.5								1		X														
		C	VD-024	72	10			5.00					2			2		X										4	
		C	MM	6	10		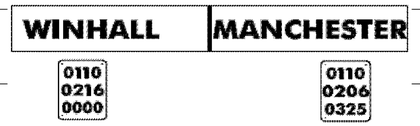	0.42																				E-138
		C	MM	6	10			0.42																				E-138
EB	0.035	A	UNK.				NO PARKING TOWN ORDINANCE			1				X													RETAIN TOWN SIGN			
EB	0.310	A	W11-6H	30	30								1		X															
		A	W11-6H	30	30			6.25								1		X											E-153
EB	0.360	A	VW-054R	30	30								1		X															
EB	0.463	A	VW-054R	30	30			6.25								1		X									MOVE 570' EAST OF EXISTING LOCATION			E-154
EB	0.520	A	W13-1	18	18								1		1															
		A	W1-2L	30	30								1		1															
		A	W1-2L	30	30			6.25																				X		
EB	0.735	A	R4-6	24	30			5.00								1		X							INSTALL 500 FT WEST OF FULL WIDTH TRUCK LANE	X		
EB	0.830	A	W7-3A	24	18		10 MILES PLAQUE						1		X															
		A	W0-000	30	30		MOOSE CROSSING						1																	
							SHEET TOTALS	29.59	0.00	1	0	0	~~9~~ 7	0	2	5		75											
								SF	SF	EA	EA	EA	EA	EA	EA	EA		FT											
							TOWN TOTALS	524.2	0.0	15.0	0.0	0.0	118	2.0	2.0	76		1140.0											

SIGN SUMMARY SHEET

VERMONT AGENCY OF TRANSPORTATION

PROJECT NAME: **Manchester-Springfield VT11**
PROJECT NUMBER: **STPG SIGN(25)**

FILE NAME: **Winhall VT11.xls**
PROJECT MANAGER: **N. Avery**
DESIGNED BY: **A. Gamble**
WINHALL SHEET 1

PLOT DATE: **4/6/2009**
DRAWN BY: **T. Guazzoni**
CHECKED BY: **S. Menard**
SHEET **12** OF **115**