DIR	MILEPOINT	LOCATION CODE (SHEET 2)	MUTCD CODE	WIDTH (IN)	HEIGHT (IN)	SHEETING REMARKS	SIGN LEGEND FOR POST LENGTHS AND INSTALLATION DATES SEE ORIGINAL RECORD PLANS	NEW SIGNS "A"	NEW SIGNS "B"	EXISTING SIGNS RETAIN	EXISTING SIGNS SALVAGE FROM	EXISTING SIGNS SALVAGE TO	EXISTING SIGNS REMOVE	EXIST POST RETAIN	EXIST POST REMOVE	NUMBER OF NEW POSTS	SQUARE STEEL (in) 2.00 (LB / FT) 2.16	SQUARE STEEL (in) 2.00 (LB / FT) 2.42	SQUARE STEEL (in) 2.50 (LB / FT) 3.35	TUBULAR STEEL Ø (IN) FOUNDATION	TUBULAR STEEL Ø (IN) 3.00 (LB / FT) 7.60	TUBULAR STEEL Ø (IN) 3.50 (LB / FT) 9.00	TUBULAR STEEL Ø (IN) 4.00 (LB / FT) 10.80	TUBULAR STEEL Ø (IN) 5.00 (LB / FT) 14.60	SIGN FRAME REQUIRED	REMARKS	SIGN DETAIL: DETAIL IN SHS	SIGN DETAIL: DETAIL ON SHEET NUMBER	SIGN DETAIL: DETAIL ON STD SHEET NUMBER
WINHALL VT11							"FY"-FLUORESCENT YELLOW "FYG"-FLUORESCENT YELLOW GREEN																			"SHS"-STANDARD HIGHWAY SIGNS			
		A	M6-3	21	15			2.19																		GREEN ON WHITE SHEETING	X		
		A	M3-3	24	12			2.00																		GREEN ON WHITE SHEETING	X		
		A	M1-5	24	24			4.00																					E-136B
		A	M6-1	21	15			2.19																		GREEN ON WHITE SHEETING	X		
EB	3.155	A	OM1-1	18	18		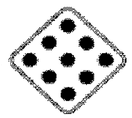						1		X														
		A	OM1-1	18	18			2.25								1	~~X~~	X									X		
EB	3.205	A	M3-2	24	12								1		X														
		A	M1-5A	24	24								1																
		A	M3-2	24	12			2.00								1		X								GREEN ON WHITE SHEETING	X		
		A	M1-5	24	24			4.00																					E-136B
EB	3.240	A	D1-1S	72	10								1		X														
		A	D2-1	72	10								1																
		A	D2-1	72	10								1																
		A	D1-1S	72	10						1		1																
		A	D1-1S	72	12			6.00				1				2		X									5		
							SHEET TOTALS	24.63	0.00	0	~~1~~ 0	~~1~~ 0	7	0	0	4		60											
								SF	SF	EA	EA	EA	EA	EA	EA	EA		FT											
							TOWN TOTALS	524.2	0.0	15.0	0.0	0.0	118	2.0	2.0	76		1140.0											

SIGN SUMMARY SHEET

VERMONT AGENCY OF TRANSPORTATION

PROJECT NAME: Manchester-Springfield VT11
PROJECT NUMBER: STPG SIGN(25)

FILE NAME: Winhall VT11.xls
PROJECT MANAGER: N. Avery
DESIGNED BY: A. Gamble
WINHALL SHEET 6

PLOT DATE: 4/6/2009
DRAWN BY: T. Guazzoni
CHECKED BY: S. Menard
SHEET 17 OF 115