DIR	MILEPOINT	LOCATION CODE (SHEET 2)	MUTCD CODE	WIDTH (IN)	HEIGHT (IN)	SHEETING REMARKS	SIGN LEGEND FOR POST LENGTHS AND INSTALLATION DATES SEE ORIGINAL RECORD PLANS	NEW SIGNS "A"	NEW SIGNS "B"	EXISTING SIGNS RETAIN	EXISTING SIGNS SALVAGE FROM	EXISTING SIGNS SALVAGE TO	EXISTING SIGNS REMOVE	EXIST POST RETAIN	EXIST POST REMOVE	NUMBER OF NEW POSTS	SQUARE STEEL (in) 2.00 (LB/FT) 2.16	SQUARE STEEL (in) 2.00 (LB/FT) 2.42	SQUARE STEEL (in) 2.50 (LB/FT) 3.35	TUBULAR STEEL FOUNDATION	TUBULAR STEEL Ø (IN) 3.00 (LB/FT) 7.60	TUBULAR STEEL Ø (IN) 3.50 (LB/FT) 9.00	TUBULAR STEEL Ø (IN) 4.00 (LB/FT) 10.80	TUBULAR STEEL Ø (IN) 5.00 (LB/FT) 14.60	SIGN FRAME REQUIRED	REMARKS	SIGN DETAIL: DETAIL IN SHS	SIGN DETAIL: DETAIL ON SHEET NUMBER	SIGN DETAIL: DETAIL ON STD SHEET NUMBER
WINHALL VT11							"FY"-FLUORESCENT YELLOW "FYG"-FLUORESCENT YELLOW GREEN																				"SHS"-STANDARD HIGHWAY SIGNS			
		F	R3-7L	~~30~~ ~~24~~	30		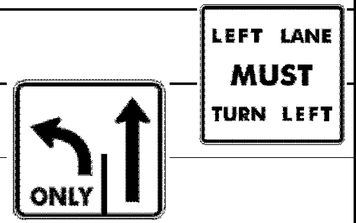	~~6.25~~ ~~5.00~~								1		X									X		
WB	3.189	F	VR-921L	30	30								1		X														
		F	VR-921L	30	30			6.25								1		X											E-145A
WB	3.153	F	M3-3	24	12		ROUTE MARKER ASSEMBLY						1	X													RETAIN POSTS, REPLACE SIGNS			
		F	M1-5A	24	24								1																
		F	M6-1	21	15								1																
		F	M3-1	24	12								1																
		F	M1-5A	24	24								1																
		F	M6-3	21	15								1																
		F	M3-4	24	12								1																
		F	M1-5A	24	24								1																
		F	M6-3	21	15								1																
		F	M3-3	24	12			2.00																		#3	GREEN ON WHITE SHEETING	X	7	
		F	M1-5A	24	24			4.00																					E-136B
		F	M6-1	21	15			2.19																			GREEN ON WHITE SHEETING	X		
							SHEET TOTALS	~~20.69~~ ~~19.44~~ SF	0.00 SF	0 EA	0 EA	0 EA	10 EA	0 EA	0 EA	2 EA	30 FT								
							TOWN TOTALS	524.2	0.0	15.0	0.0	0.0	118	2.0	2.0	76	1140.0											

SIGN SUMMARY SHEET

VERMONT AGENCY OF TRANSPORTATION

PROJECT NAME: **Manchester-Springfield VT11**
PROJECT NUMBER: **STPG SIGN(25)**

FILE NAME: **Winhall VT11.xls**
PROJECT MANAGER: **N. Avery**
DESIGNED BY: **A. Gamble**
WINHALL SHEET 10

PLOT DATE: **4/6/2009**
DRAWN BY: **T. Guazzoni**
CHECKED BY: **S. Menard**
SHEET **21** OF **115**